

Sowley

Map No. KANSAS Sec. 9 Twp. 32 R. 4


Well No. 3-Mitchell Farm
Prairie & McVabb Company

_____ Ft. from N. Line

300 Ft. from S. Line

1279 Ft. from E. Line

_____ Ft. from W. Line

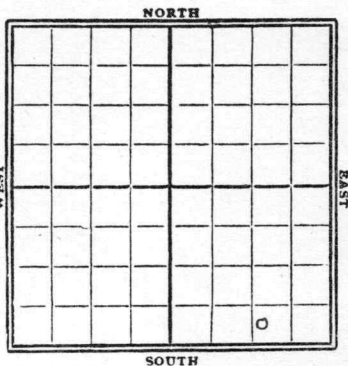

1929

Date

REPORT

Date	REPORT
5/15	Bldg Rig
5/22	Rig up
5/29	Drill 650'
6/5	" 1580'
6/12	" 1725'
6/19	" 2305'
6/26	" 2540'
7/2	" 3040'
7/10	Splice line 3311-17 hole full fluid
7/17	sand 3311-17 TD. 3317 250 bbl oil 250 " water Pump.

Map No. ² **KANSAS** Sec. ⁹ Twp. ³² R. ⁴

Well No. ³ *Mitchler*

Prairie & McRabb Company

Contractor

FIRST REPORTS

SECTION PLAT

..... Ft. from N. Line

300 Ft. from S. Line

1279 Ft. from E. Line

..... Ft. from W. Line

			o

Location.....

Rig up *Bldg Rig*

Drilling and Remarks:

RECORD

Cased..... in., ft.

Sand.....

Gas.....

Oil.....

Total Depth.....

PRODUCTION

1st 24 hrs. Nat.....

1st 24 hrs. after shot.....

Gas..... Cu. Ft.

Dry Hole.....

Abandoned.....

Date

MAY 15 1929

..... 192..... Scout

CHAS. L. SHERWOOD

Cowley

Map No. KANSAS Sec. 9 Twp. 32 R. 4

Well No. 3 Mitchler

Prairie of Mc Nab Company

Contractor

COMPLETE

SECTION PLAT

			0

_____ Ft. from N. Line

300 Ft. from S. Line

1279 Ft. from E. Line

_____ Ft. from W. Line

Location _____

Rig up _____

Drilling and Remarks:

250 lbs Oil
250 lbs Water

RECORD

Cased _____ in., _____ ft.

Sand 3311-3317

Gas _____

Oil _____

Total Depth 3317

PRODUCTION

1st 24 hrs. Nat. _____

1st 24 hrs. after shot _____

Gas _____ Cu. Ft.

Dry Hole _____

Abandoned _____

Date
JUL 17 1929

CHAS. L. SHERWOOD