


Section 9 Township 32 Range 4 E

Well No. #2  
~~#1~~ W. D. Mitchler

Company K. T. Weidemann (Mitschler)

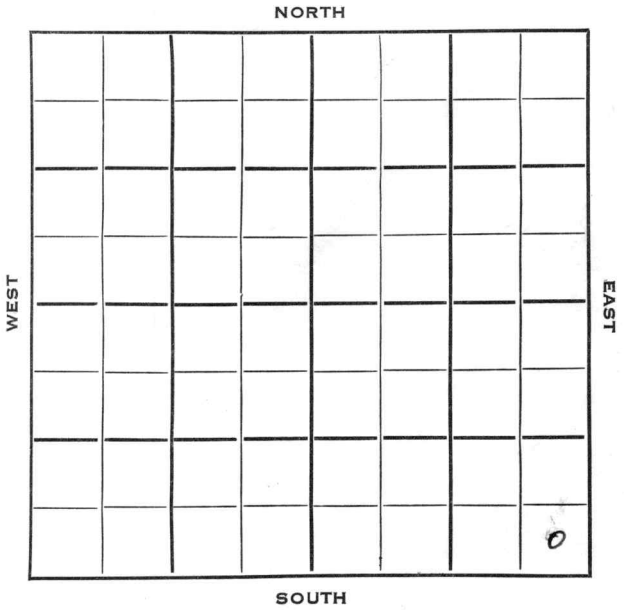

SEC.	TWP.	R.
9	32	4E

WELL NO. <sup>#2</sup> ~~1~~ W. D. Mitchler FARM

COMPANY  
K. T. Weidemann

CONTRACTOR


State Pool

\_\_\_\_\_ Ft. from N. Line

330 \_\_\_\_\_ Ft. from S. Line

330 \_\_\_\_\_ Ft. from E. Line

\_\_\_\_\_ Ft. from W. Line

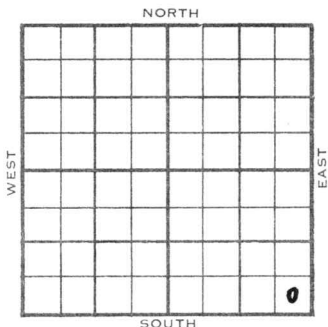

SE SE SE

1954	ELEVATION 1176'	REPORT
------	--------------------	--------

6/23  
7/28

MIR  
Spud 6-22-54  
Oil Well  
TD 3289'  
10" @ 130'  
Miss 2962', Arb. 3286'  
TD 3288'  
5" @ 3287'  
DD 3289'  
FU 1488' oil 24 hrs.  
Comp. 25 bopd

COMPLETED



Kansas

Map No. \_\_\_\_\_ Sec. 9 Twp. 32 R. 4E

Well No. 2 W. D. Mitchler

K. T. Weidemann Company

**CORRECTION** Contractor

SE SE SE

SECTION PLAT

\_\_\_\_\_ Ft. from N. Line

330 Ft. from S. Line

330 Ft. from E. Line

\_\_\_\_\_ Ft. from W. Line

			p

Cowley County

Location \_\_\_\_\_

Rig up \_\_\_\_\_

Drilling and Remarks:

Reported  
#1 Mitchler

RECORD

Cased \_\_\_\_\_ in., \_\_\_\_\_ ft.

Sand \_\_\_\_\_

Gas \_\_\_\_\_

Oil \_\_\_\_\_

Total Depth \_\_\_\_\_

PRODUCTION

1st 24 hrs. Nat. \_\_\_\_\_

1st 24 hrs. after shot \_\_\_\_\_

Gas \_\_\_\_\_ Cu. Ft.

Dry Hole \_\_\_\_\_

Abandoned \_\_\_\_\_

Date

JUN 30 1954<sub>19</sub>

J. G. MCGEHEE Scout

