

Cowley

KANSAS

SECTION 9 TOWNSHIP 32 RANGE 4E

WELL NO. #1 Tharp

COMPANY Time Petroleum

NORTH

	0						

WEST

EAST

SOUTH

Cowley

KANSAS

SEC. 9	TWP. 32	R. 4E
-----------	------------	----------

WELL NO.

#1 Tharp

FARM

COMPANY

Time Petroleum

CONTRACTOR

Kirkpatrick


State

Ft. from N. Line

Ft. from S. Line

Ft. from E. Line

Ft. from W. Line

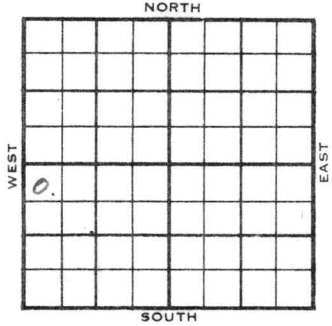

NW NW SW

1956	ELEVATION xxxx 1117'	REPORT
------	------------------------------------	--------

5-9
 Comm. 5-4-56
 8." @ 120
 Drlg. 1800
 (Tite Hole)

5-23
 D&A
 Lay 2339'
 TD 2425'

ABANDONED

County Cowley Elev. _____
 Sec. 9 Twp. 32 Rgs. 4E
 Company Time Petroleum
 Farm Name Tharp No. 1

TOPS	DEPTH	LOG	DATUM
Anh.			
Tp.			
H.			
Tr.			
Dg.			
Bl.			
L.			
K.C.			
B.K.C.			
Ce.			
C.			
M.			
M.			
K.			
Mz.			
Mq.			
V.			
S.			
S.			
A.			
R.			
Pf.			
G.			
T.D.			

Loc. in Sec. NW NW SW
 Geol. _____
 Contr. Kirkpatrick
 Pool _____
 State _____

FIRST REPORT
 MAY 9 '56

Date Comm. 5-4-56 TITE HOLE
8" @ 120 drlg. 1800

MAY 14 1956
 R.G.

29

Co.
 Use
 No.
 Sec.
 T.
 R.

County Cowley Elev. 1177
 Sec. 9 Twp. 32 Rgs. 4E
 Company Time Petroleum
 Farm Name Tharp No. 1

TOPS	DEPTH	LOG	DATUM	Loc. in Sec.
				NW NW SW
H- <u>224</u>	<u>2339</u>			
Tr.				
Dg.				
Bl.				
L.				Geol.
K.C.				Contr.
B.K.C.				<u>Kirkpatrick</u>
Ce.				Pool
C.				State
M.				
M.				
K.				
Mz.				
Mo.				
V.				
S.				
S.				
A.				
R.				
PE.				
G.				
TD.	<u>2425</u>			

ABANDONED
 MAY 28 1956

Date Comm. 5-1-56 TITE HOLE

8" @ 120 drlg. 1800 MAY 15 '56 2410 TD

MAY 23 '56

D&A

D&A (hold)

Co.

Use.

No.

Sec.

T.

R.