

Cowley


KANSAS

SECTION 9 TOWNSHIP 32 RANGE 4E

WELL NO. #2 Tharp

COMPANY Time Petroleum

NORTH

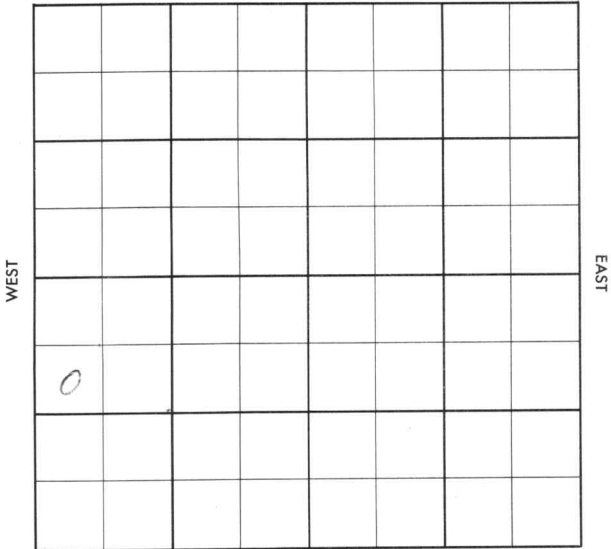

SOUTH

Cowley

KANSAS


|           |            |          |
|-----------|------------|----------|
| SEC.<br>9 | TWP.<br>32 | R.<br>4E |
|-----------|------------|----------|

WELL NO. #2 Tharp FARM

COMPANY Time Petroleum  
CONTRACTOR

State

\_\_\_\_\_ Ft. from N. Line  
 \_\_\_\_\_ Ft. from S. Line  
 \_\_\_\_\_ Ft. from E. Line  
 \_\_\_\_\_ Ft. from W. Line

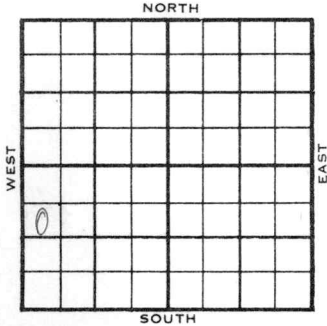

SW NW SW

1956 ELEVATION 1187' REPORT

5-16 Drlg. (Tite Hole)  
~~#~~

7-3 D & A (TITE)  
 TD 2426'.

ABANDONED



M  
29

County Cowley Elev. 1187  
 Sec. 9 Twp. 32 Rge. 4E  
 Company Time Petroleum  
 Farm Name Tharp No. 2

| TOPS   | DEPTH       | LOG | DATUM |
|--------|-------------|-----|-------|
| Anh.   |             |     |       |
| TP.    |             |     |       |
| H.     |             |     |       |
| Tr.    |             |     |       |
| Dg.    |             |     |       |
| BL.    |             |     |       |
| L.     |             |     |       |
| K.C.   |             |     |       |
| B.K.C. |             |     |       |
| Ce.    |             |     |       |
| C.     |             |     |       |
| M.     |             |     |       |
| M.     |             |     |       |
| K.     |             |     |       |
| Mz.    |             |     |       |
| Ma.    |             |     |       |
| V.     |             |     |       |
| S.     |             |     |       |
| S.     |             |     |       |
| A.     |             |     |       |
| R.     |             |     |       |
| PE.    |             |     |       |
| G.     |             |     |       |
| T.D.   | <u>2426</u> |     |       |

Loc. in Sec. SW NW SW  
 Geol. \_\_\_\_\_  
 Contr. \_\_\_\_\_  
 Pool \_\_\_\_\_  
 State \_\_\_\_\_

ABANDONED  
 JUL 3 1956

Date Comm. drlg. MAY 23 '56 MAY 29 '56 JUN 6 '56 JUN 13 '56  
JUN 20 '56 JUN 27 '56 JUL 3 '56

*Never get dope*

*D&a Tite*

Co. Lse. No. Sec. T. R.