

Map No. _____ Sec. 10 Twp. 32 R. 4

Well No. 1 - Graham Farm

Imo oil Company


_____ Ft. from N. Line

330 Ft. from S. Line

_____ Ft. from E. Line

330 Ft. from W. Line

1927

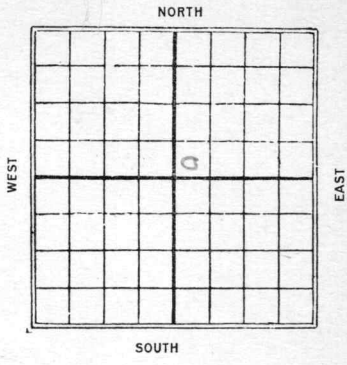

Date	REPORT
------	--------

3/24	R. O. G.
3/30	Rig
4/7	Drlg 250
4/13	" 820
4/20	S.D. 1400
4/27	Drlg 1740
5/5	Setting 8" - 2300
5/12	Sand 2583-2672 good show oil + H.F.W. - Drilling 2700
5/18	Drlg around 3000' refuse to give out information
5/25	Wilcox 3432-34. H.F.W. P.B. to sand 2583-2673-
6/11	—
6/7	—
6/16	D & A. 3434'

2 KANSAS

Cowley

Map No. _____ Sec. 10 Twp. 32 R. 4

Well No. 1 _____

Imo oil Co _____ Company

_____ Contractor

FIRST REPORTS

SECTION PLAT

_____ Ft. from N. Line

330

_____ Ft. from S. Line

_____ Ft. from E. Line

330

_____ Ft. from W. Line

		o	

Location _____

Rig up _____

Drilling and Remarks:

ROS

RECORD

Cased _____ in., _____ ft.

Sand _____

Gas _____

Oil _____

Total Depth _____

PRODUCTION

1st 24 hrs. Nat. _____

1st 24 hrs. after shot _____

Gas _____ Cu. Ft.

Dry Hole _____

Abandoned _____

Date

MAR 24 1927

CHAS. L. SHERWOOD

192

Scout

Cowley

2 KANSAS Map No. Sec. 10 Twp. 32 R. 4

Well No. 1 Graham

Ino Oil Co Company

Contractor

COMPLETED

SECTION PLAT

_____ Ft. from N. Line

330 Ft. from S. Line

_____ Ft. from E. Line

330 Ft. from W. Line

ABANDONED

		o	

Location _____

Rig up _____

Drilling and Remarks:

Land 2583-2673
 Good showy oil
 Wilcox 3432-3434
 AFW
 JH 3434

RECORD

Cased _____ in., _____ ft.

Sand _____

Gas _____

Oil _____

Total Depth 2434

PRODUCTION

1st 24 hrs. Nat. _____

1st 24 hrs. after shot _____

Gas _____ Cu. Ft.

Dry Hole ✓

Abandoned ✓

Date

JUN 16 1927

CHAS. L. SHERWOOD

192

Scout

Cowley

MAP NO. KANSAS SEC. 10 TWP. 37S R. 1E

WELL No. 1 Graham

Iron Oil COMPANY

CONTRACTOR

SECTION PLAT

ABANDONED

_____ FT. FROM N. LINE

_____ FT. FROM S. LINE

_____ FT. FROM E. LINE

_____ FT. FROM W. LINE

RECORD

LOCATION _____

RIG UP _____

DRILLING AND REMARKS:

CASED _____ IN., _____ FT.

SAND _____

GAS _____

OIL _____

TOTAL DEPTH 3434

PRODUCTION

1ST 24 HRS. NAT. _____

1ST 24 HRS. AFTER SHOT _____

GAS _____ CU. FT.

DRY HOLE ✓

ABANDONED ✓

DATE

6/14 192 7

SCOUT