

Sowley

Map No. KANSAS Sec. 10 Twp. 32 R. 4

Well No. 4 - Graham Farm
M^c Nabbs & Prairie Company


_____ Ft. from N. Line

750 Ft. from S. Line

_____ Ft. from E. Line

250 Ft. from W. Line

1929

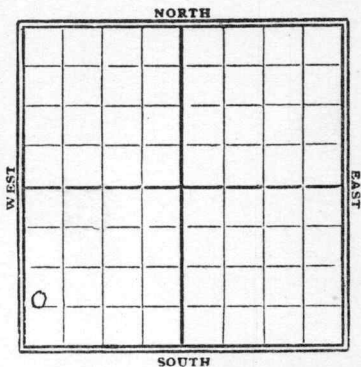

Date	REPORT
2/27	Bldg Rig
3/6	Ran up.
3/13	Only 375'
3/20	" 1380'
3/27	" 1785'
4/3	" 2055'
4/10	setg 8" - 2415'
4/17	UTR 8" - 2480'
4/24	Only 2785'
5/1	" 3260'
5/8	Top Oil line 3293 T.D. 3301' P.B. to 3297 75 bbls oil
5/15	Sand 3293 - 3301' T.D. 3301' P.B. to 3297 75 bbls oil Song.

Cowley 37

Map No. **2 KANSAS** Sec. *10* Twp. *37* R. *4*

Well No. *4* *Graham*

McKabb & Prairie Company

Contractor

FIRST REPORTS

SECTION PLAT

Ft. from N. Line

750 Ft. from S. Line

Ft. from E. Line

250 Ft. from W. Line

Location

Rig up

Drilling and Remarks:

Bldg Rig

RECORD

Cased.....in.,ft.

Sand.....

Gas.....

Oil.....

Total Depth.....

PRODUCTION

1st 24 hrs. Nat.....

1st 24 hrs. after shot.....

Gas.....Cu. Ft.

Dry Hole.....

Abandoned.....

Date

FEB 27 1929

CHAS. L. SHERWOOD

192

Scout

Cowley

Map No. **2 KANSAS** Sec. *10* Twp. *32* R. *4*

Well No. *4 Graham*

The North 8 Prairie Company

Contractor

COMPLETE

SECTION PLAT

..... Ft. from N. Line

750 Ft. from S. Line

..... Ft. from E. Line

750 Ft. from W. Line

<i>0</i>			

Location.....

Rig up.....

Drilling and Remarks:

PB To 3297

75 Bls.

RECORD

Cased..... in., ft.

Sand *3293-3301*

Gas.....

Oil.....

Total Depth *3301'*

PRODUCTION

1st 24 hrs. Nat.....

1st 24 hrs. after shot.....

Gas..... Cu. Ft.

Dry Hole.....

Abandoned.....

Date

MAY 15 1929

CHAS. L. SHERWOOD

..... 192.....

..... Scout