

Map No. KANSAS Sec. 11 Twp 32 R. 4^E

Well No. 1 - Forsythe Farm
Wm M^o Knabb Company


_____ Ft. from N. Line

330 Ft. from S. Line

_____ Ft. from E. Line

750
~~330~~ Ft. from W. Line

1933

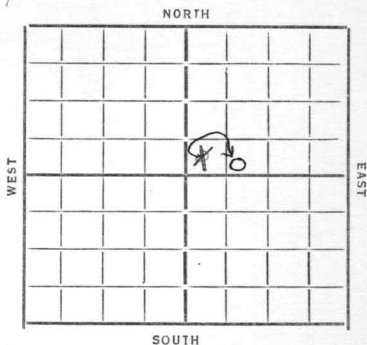

Date	REPORT
1/11	Cellar
1/18	_____
1/25	_____
2/11	m.l.m.
2/8	_____
2/15	_____
2/22	Bldg rig
3/4	Rig
3/8	_____
3/10	Hrly 800'
3/22	12" - 1101 - July 1505
3/29	11. P. 10" 1727'
4/4	10" 1728' N.7.W 1970' 8" 2150 dely 2317
4/12	S.D.
4/19	show @ 2483 N.7.W 2524-38'
	6" 2780' dely 2794'
4/26	Top Chat 3020 Hrly 3170
5/3	Top Siliceous Lime 3439 water 3445 <u>Abandoned</u>

Crowley

2 KANSAS Sec. 11 Twp. 32 R. 4 E

Well No. 1 *Forsythe*

N. M. McKee Company

Contractor

FIRST REPORTS

Ft. from N. Line
330 Ft. from S. Line
Ft. from E. Line
330 Ft. from W. Line

SECTION PLAT

Location
Rig up
Drilling and Remarks:

Cellar

RECORD

Cased.....in.,ft.
Sand.....
Gas.....
Oil.....
Total Depth.....

PRODUCTION

1st 24 hrs. Nat.....
1st 24 hrs. after shot.....
Gas.....Cu. Ft.
Dry Hole.....
Abandoned.....

Date

JAN 1 1 1933

CHAS. L. SHERWOOD

192 Scout

Cowley

E

2 KANSAS

Map No. Sec. 11 Twp. 32 R. 4

Well No. 1 Forsythe

N. M. McInabbe Company

Contractor

CORRECTION


..... Ft. from N. Line

330 Ft. from S. Line

..... Ft. from E. Line

750 Ft. from W. Line

SECTION PLAT

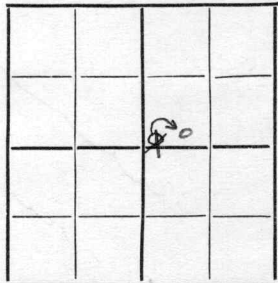

Location.....

Rig up.....

Drilling and Remarks:

Chy Location to above

RECORD

Cased..... in., ft.

Sand.....

Gas.....

Oil.....

Total Depth.....

PRODUCTION

1st 24 hrs. Nat.....

1st 24 hrs. after shot.....

Gas..... Cu. Ft.

Dry Hole.....

Abandoned.....

Date

MAR 29 1933

192 CHAS. L. SHERWOOD Scout

Crowley

E

2 **KANSAS** Map No. Sec. *11* Twp. *32* R. *4*

Well No. *1* *Forsyth*

W. M. McKnabb Company

Contractor

COMPLETED

SECTION PLAT

		o	

..... Ft. from N. Line

330 Ft. from S. Line

..... Ft. from E. Line

750 Ft. from W. Line

ABANDONED

Location.....

Rig up.....

Drilling and Remarks:

Top Dilic sand
Line 3439
Water 3445
D & A

RECORD

Cased..... in., ft.
Sand.....
Gas.....
Oil.....
Total Depth *3445*

PRODUCTION

1st 24 hrs. Nat.....
1st 24 hrs. after shot.....
Gas..... Cu. Ft.
Dry Hole
Abandoned

Date

MAY 3 1933