


Section 25 Township 27 Range 8E

Well No. #31 Lewis

Company K.T. Weideman

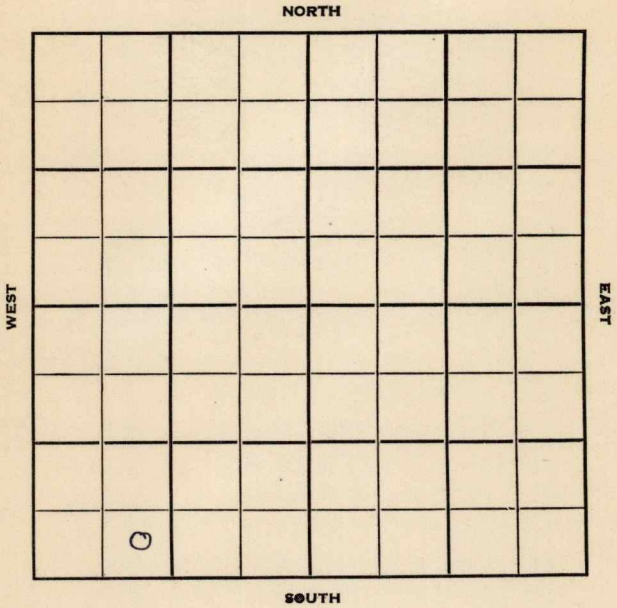

Greenwood

KANSAS

Sec. 25 Twp. 27 R. 8E

Well No. #31 Lewis Farm

K.T. Weideman Company

Contractor


Ft. from N. Line

430 Ft. from S. Line

Ft. from E. Line

990 Ft. from W. Line

SE SW SW (Twin)

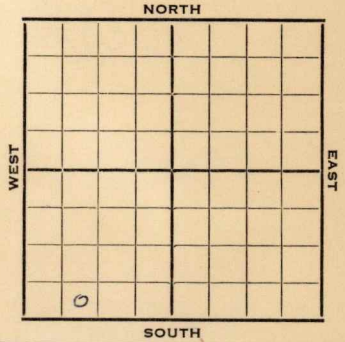

1952

REPORT

4/2

Spud 3-31-52

Arb. Test

4/30

Spud 3-31-52

Oil Well TD 2780'

KC 1681 Miss. 2435 Arb. 2737

TD 2780 5" @ 2780' 36/ 2737-42

12/ 2737-42 350 A

Comp. 25 bopd 25 bw

COMPLETED

County Greenwood State Kansas

Sec. **25** (Blk.) **27** (Sur.) **8E** Map No.

Operator K. T. Weideman

Well No. 31 Farm Lewis

Elev.	Location
	SE SW SW (twin well)

0

FIRST REPORT

430 Ft. From S Line SW

990	Ft. From	Line	Quarter
-----	----------	------	---------

1st. Report APR 2 1952

Completion

Remarks

Spudding Date 3-31-52

Drig. Data

Arb test

J. G. McGEHEE

County Greenwood State Kansas
 Sec. 25 (Blk. 27 (Sur. 8E Map No.)
 (Twp.) (Rge.)

Operator K. T. Weidemann

Well No. 31 Farm Lewis

Elev. Location SE SW SW (twin well)



430 Ft. From S Line SW

990 Ft. From W Line Quarter

1st. Report

Completion APR 30 1952

Remarks

Spudding Date 3-31-52

Drlg. Data Oil well TD 2780

KC 1681 Miss. 2435 Arb. 2737

TD 2780 5" @ 2780 36/ 2737-42

12/ 2737-42 350 A Comp. 25 bopd 25 bw

J. G. McGEHEE