

Section 12 Township 32 Range 4E

Well No. #1 Brant

Company Laura Jane

NORTH

				0			

WEST

EAST

SOUTH

Sec. 12 Twp. 32 R. 4E

Well No. #1 Brant Farm

Laura Jane Company

Laura Jane Contractor


Biddle Pool

330 Ft. from N. Line

Ft. from S. Line

Ft. from E. Line

330 Ft. from W. Line

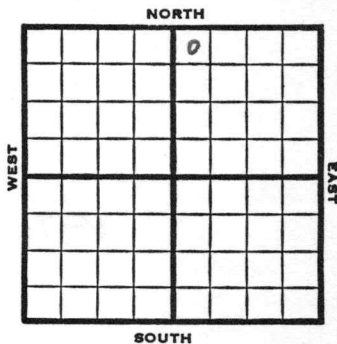

NW NW NE

1953 Elev. 1243' REPORT

8/12 Spud 7-8-53  
10" @ 104'  
Drlg. 200'

9/2 Spud 7-8-53  
D & A  
TD 2967'  
10" @ 104'  
Layton 2354, KC 2458, Oswego 2695,  
Bart 2933  
TD 2967  
5" @ 2948'  
CO to 2967 16/ 2941-44 F/ wtr & SSO  
st-frac S & F/wtr.  
SP 2371  
18/ 2349-52 st-frac wtr.  
DST 2349-54 opn 1 hr, rec 240' mud  
678#  
D & A

ABANDONED

County **Cowley** State **Kansas**

Sec. **12** (Blk.) **32** (Sur. Rge.) **4E** Map No.

Operator **Laura Jane**

Well No. **1** Farm **Brant**

Elev. Location **NW NW NE**


**330** Ft. From **N** Line **NE**

**330** Ft. From **W** Line **Quarter**

1st. Report **AUG 12 1953**

Completion

Remarks

**Laura Jane - Contr.**

Spudding Date **7-8-53**

Drlg. Data **Biddle Pool**

**10" @ 104 drlg. 200**

