


Cowley

KANSAS

SECTION 12 TOWNSHIP 32 RANGE 4E

WELL NO. #1 Brant

COMPANY McNeish & Gralapp

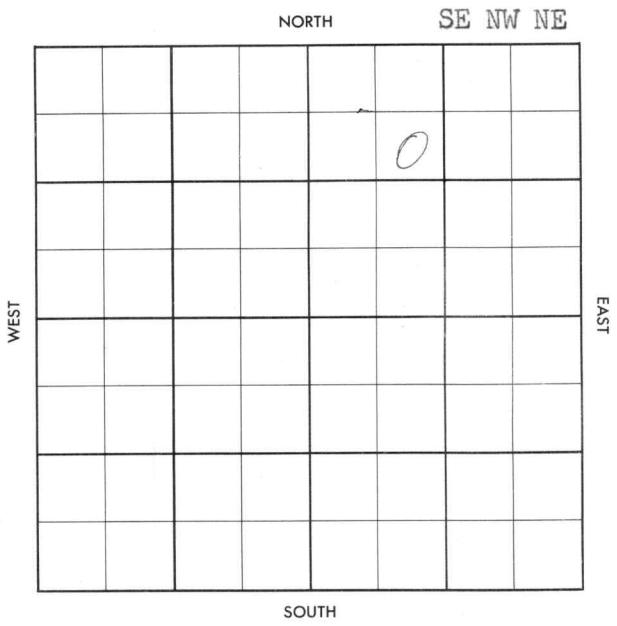

County Cowley Elev. \_\_\_\_\_  
 Sec. 12 Twp. 32 Rge. 4E  
 Company McNeish & Gralapp  
 Farm Name Brant No. 1

TOPS	DEPTH	LOG	DATUM
Anh.			
Tp.			
H.			
Tr.			
Dg.			
Bl.			
L.			
K.C.			
B.K.C.			
Ce.			
C.			
M.			
M.			
K.			
Mz.			
Me.			
V.			
S.			
S.			
A.			
R.			
PE.			
G.			
T.D.			

Loc. in Sec. SE NW NE

Geol. \_\_\_\_\_  
 Contr. Watson Drlg.

Pool Biddle

		O	
		MAY 8 '57	

FIRST REPORT

Date Comm. 5-5-57  
8" @ 200/150, WOC

*29*

Co.

Lse.

no.

sec.

l.

R.

County Cowley Elev. 1248  
 Sec. 12 Twp. 32 Rgs. 4E  
 Company McNeish & Gralapp  
 Farm Name Brant No. 1

TOPS	DEPTH	LOG	DATUM
Anh.			
Tp. <u>stain</u>		<u>1924</u>	
H.			
Tr. <u>Loaf</u>		<u>2340</u>	
Dg.			
BL.			
L.			
K.C.		<u>2464</u>	
B.K.C.			
Ce. <u>OSW</u>		<u>2704</u>	
C. <u>cattle</u>		<u>2952</u>	
M.		<u>3053</u>	
M.			
K.			
Mz.			
Mo.			
V.			
S.			
S.			
A.			
R.			
PE.			
G.			
T.D.	<u>3066</u>		

Loc. in Sec. SE NW NE  
 Geol. \_\_\_\_\_  
 Contr. \_\_\_\_\_  
Watson Drlg.  
 Pool \_\_\_\_\_  
Biddle  

	0	
	MAY 22 '57	

**ABANDONED**

Date Comm. 5-5-57  
8" @ 200/150, WOC MAY 15 '57 12 3043  
MAY 22 '57 cid 2341-53 Full rec  
S.O.

DEW

Co.  
No.  
Sec.  
T.  
R.