


Cowley

Map No. KANSAS Sec. 12 Twp. 32 R. 4E

Well No. 2-"A" Brant Farm
Roth & Fourat Company

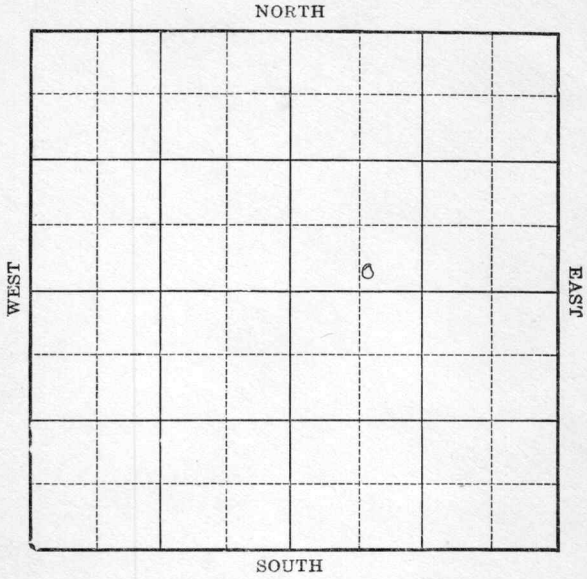

Location _____
Drilling Remarks _____

Rig Up _____
Drilling Remarks _____

RECORD

Cased _____ in. _____ ft.

Sand _____

Gas _____

Oil _____

Total Depth _____

PRODUCTION

1st 24 hrs. Nat. _____

1st 24 hrs. after shot _____

Gas _____ cu. ft. _____

Dry Hole _____


Abandoned _____

Cowley

Map No. KANSAS Sec. 12 Twp. 32 R. 4^E

Well No. 2-A Blant Farm
Roth & Fowrat Company

NORTH

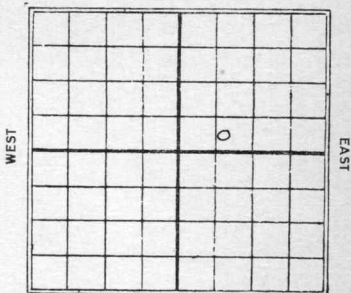

_____ Ft. from N. Line

225 Ft. from S. Line

_____ Ft. from E. Line

685 Ft. from W. Line

1930

Date

REPORT

10/22

Sand 722-738
T.D. 738
1A gas
Comp.

Cowley

Map No. KANSAS Sec. 12 Twp. 32 R. 4 ^E

Well No. 2 a" Brant

Roth & Janot Company

FIRST REPORTS

Contractor

COMPLETE

SECTION PLAT

_____ Ft. from N. Line

285 Ft. from S. Line

_____ Ft. from E. Line

685 Ft. from W. Line

Location _____

Rig up _____

Drilling and Remarks:

RECORD

Cased _____ in., _____ ft.

Sand 722-738

Gas _____

Oil _____

Total Depth 738

PRODUCTION

1st 24 hrs. Nat. _____

1st 24 hrs. after shot _____

Gas 1 A Cu. Ft.

Dry Hole _____

Abandoned _____

Date
OCT 2 2 1930

CHAS. L. SHERWOOD