


Sawley

Map No. KANSAS Sec. 12 Twp. 33^S R. 4^E

Well No. 3 - Johnson Farm

Worley Company

NORTH

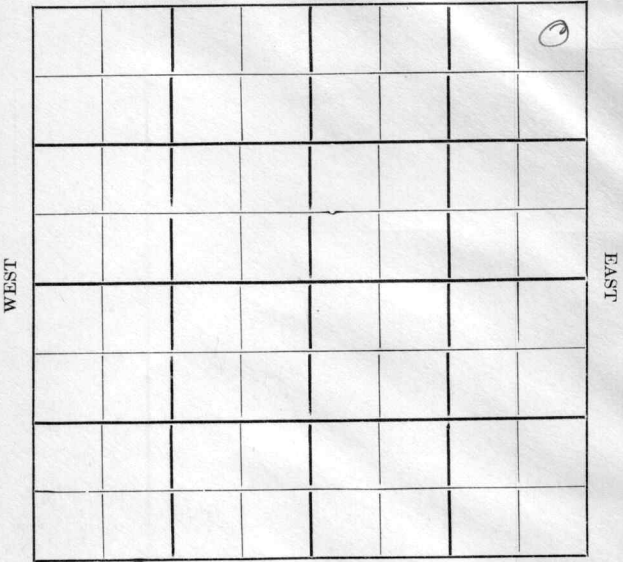

SOUTH

Location.....

Drilling Remarks

.....

.....

Rig Up.....

Drilling Remarks

.....

.....

RECORD

PRODUCTION

Cased..... in..... ft.

Sand.....

Gas.....

Oil.....

Total Depth.....

1st 24 hrs. Nat.....

1st 24 hrs. after shot.....

Gas..... cu. ft.....

Dry Hole.....

Abandoned.....

Map No. Sec. Twp. R.

Well No. Farm


..... Company

..... Ft. from N. Line

..... Ft. from S. Line

..... Ft. from E. Line

..... Ft. from W. Line

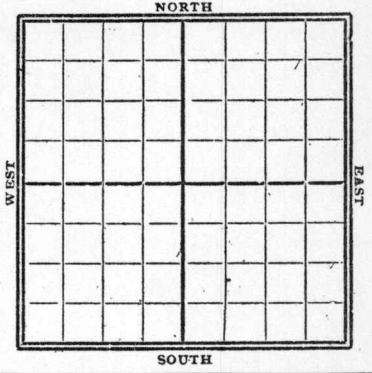

1915

Date

REPORT

Gypsy Records

7/30

Abd T.D. 712'

Carley

MAP NO. K2 KANSAS SEC. ✓ TWP. 33S R. 4E

WELL NO. 3 Johnson

Merby COMPANY

CONTRACTOR

SECTION PLAT

ABANDONED

_____ FT. FROM N. LINE

_____ FT. FROM S. LINE

_____ FT. FROM E. LINE

_____ FT. FROM W. LINE

			0

RECORD

LOCATION _____

RIG UP _____

DRILLING AND REMARKS:

CASED _____ IN., _____ FT.

SAND _____

GAS _____

OIL _____

TOTAL DEPTH 712

PRODUCTION

1ST 24 HRS. NAT. _____

1ST 24 HRS. AFTER SHOT _____

GAS _____ CU. FT.

DRY HOLE ✓

ABANDONED ✓

DATE

July 30 1925

SCOUT