


Section 17 Township 27 Range 5-E

Well Number #1-Smilley

Company Dalton et al

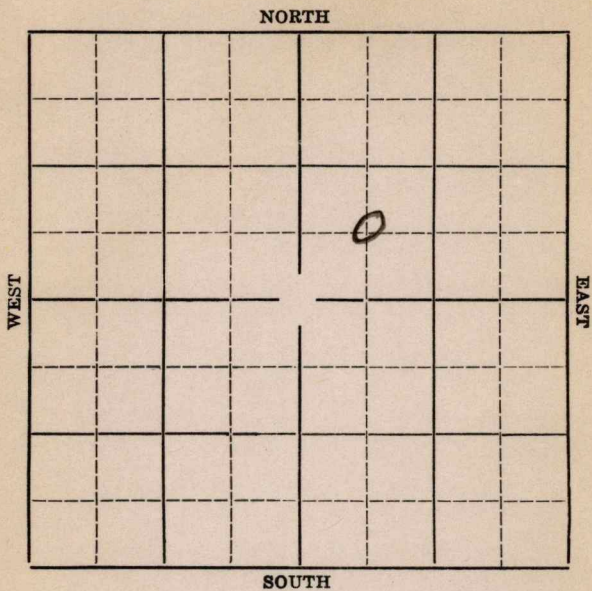


KANSAS

Map No. _____ Sec. 17 Twp. 27 R. 5-E

Well No. 1-Smilley Farm _____

Dalton et al Company _____

NORTH

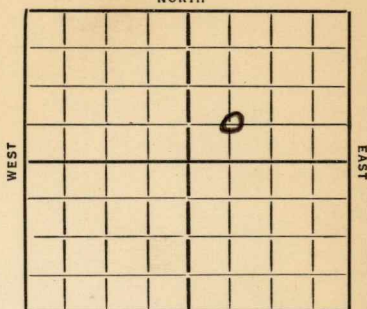

SOUTH

_____ Ft. from N. Line

660 Ft. from S. Line

_____ Ft. from E. Line

660 Ft. from W. Line

Date
1936

REPORT

4/29 Machine
5/7 S.D. 140'.
5/14 -- 5/21 -- 5/28 -- 6/4 -- 6/12 -- ~~6/18~~
6/18 Drlg. 270'.
6/25 Drlg. 350'.
7/2 Shut down.
7/9 -- 7/16 -- 7/23 -- 8/30 -- 8/6 -- 8/13 --
8/20 -- 8/27 -- 9/3 --

9/23/36 - T.D. 440'.
Dry and abandoned.

ABANDONED

KANSAS

Map No. 11 Sec. 17 Twp. 27 R. 5EWell No. 1 SmiffeyDalton & Dal Company

Contractor

SECTION PLAT

		0	

 Ft. from N. Line660 Ft. from S. Line Ft. from E. Line660 Ft. from W. Line

FIRST REPORT

Location Rig up

Drilling and Remarks:

Mach

RECORD

Cased in., ft.Sand Gas Oil Total Depth

PRODUCTION

1st 24 hrs. Nat. 1st 24 hrs. after shot Gas Cu. Ft.Dry Hole Abandoned

Date

4/291936J. Lewis Scout

KANSAS

Map No. 11 Sec. 17 Twp. 27 R. 5EWell No. 1 SmileyDalton (E) & Co. Company

Contractor

SECTION PLAT

		0	

_____ Ft. from N. Line

660 Ft. from S. Line

_____ Ft. from E. Line

660 Ft. from W. Line

ABANDONED

Location _____

Rig up _____

Drilling and Remarks:

J & A

RECORD

Cased _____ in., _____ ft.

Sand _____

Gas _____

Oil _____

Total Depth 440

PRODUCTION

1st 24 hrs. Nat. _____

1st 24 hrs. after shot _____

Gas _____ Cu. Ft.

Dry Hole _____

Abandoned _____

Date

SEP 23 1936

19

S. J. LEWIS Scout