



Russell

**KANSAS**

Sec. 26 Twp. 13 R. 15W

Well No. #1 Cook (D) Farm

Texas et al Company

Anchultz Contractor  
Cook


990 Ft. from N. Line

\_\_\_\_\_ Ft. from S. Line

\_\_\_\_\_ Ft. from E. Line

990 Ft. from W. Line

SE NW SW

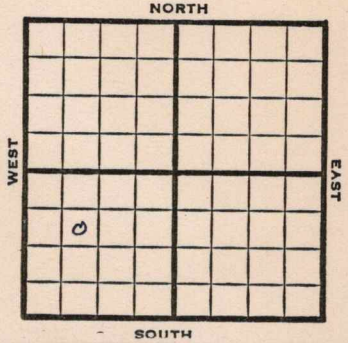

1952

**Elev. 1894'**

REPORT

1/16

Spud 1-8-52  
Drlg. 1945'

1/30

Spud 1-8-52  
D&A TD 3371

**Heeb. 3012 Lans. 3068 B KC 3266**

**Arb. 3356 TD 3371**

D&A

**ABANDONED**


County **Russell** State **Kansas**

Sec. **26** (Blk. Twp.) **13** (Sur. Rge.) **15W** Map No.

Operator **Texas etal.**

Well No. **1** Farm **Cook (D)**

Elev. **1894** Location **SE NW SW**

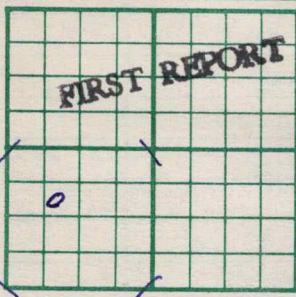

**990** Ft. From **N** Line **SW**

**990** Ft. From **W** Line **Quarter**

Ist. Report **JAN 16 1952**

Completion

Remarks

**Anchultz - Contr.**

Spudding Date **1-8-52**

Drlg. Data **Cook**

**Drlg. 1945**

**J. E. TYRA**

County Russell State Kansas

Sec. 26 (Blk. 13) (Sur. 15W) Map No.

Operator Texas etal.

Well No. 1 Farm Cook "D"

Elev. 1894 Location SE NW SW



990 Ft. From N Line SW

990 Ft. From W Line Quarter

Ist. Report

Completion JAN 30 1952

Remarks Cook Pool

Anschutz Drlg. - Contr.

Spudding Date 1-8-52

Drlg. Data D & A TD 3371

Heeb. 3012 Lans. 3068 B KC 3266

Arb. 3356 TD 3371

D & A

J. G. McGEHEE