


Map No. Kansas Sec. 13 Twp. 32 R. 4

Well No. 2 Rockwell Farm  
Marland + Nudy Company

NORTH

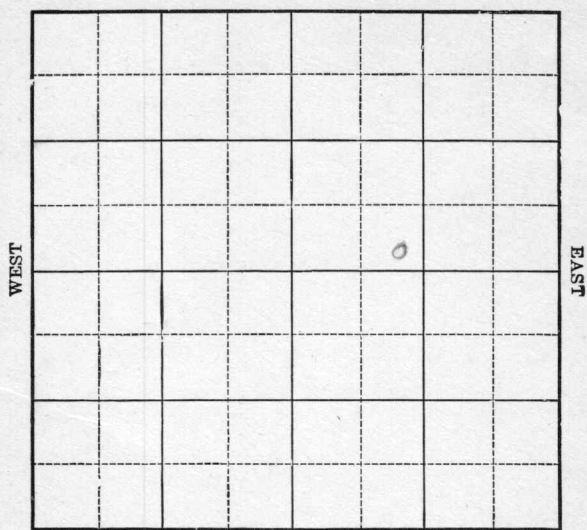

Location \_\_\_\_\_  
Drilling Remarks \_\_\_\_\_

Rig Up \_\_\_\_\_  
Drilling Remarks \_\_\_\_\_

\_\_\_\_\_

\_\_\_\_\_

**RECORD**

**PRODUCTION**

Cased \_\_\_\_\_ in. \_\_\_\_\_ ft.

Sand \_\_\_\_\_

Gas \_\_\_\_\_

Oil \_\_\_\_\_

Total Depth \_\_\_\_\_

1st 24 hrs. Nat. \_\_\_\_\_

1st. 24 hrs. after shot \_\_\_\_\_

Gas \_\_\_\_\_ cu. ft.

Dry Hole \_\_\_\_\_

Abandoned \_\_\_\_\_



Map No. 2 Sec. 13 Twp. 32 R. 4

Well No. 2 Ruckwell

Marland + Neely + Bean Company

Contractor

FIRST REPORT

----- Ft. from N. Line

300 Ft. from S. Line

----- Ft. from E. Line

1020 Ft. from W. Line

SECTION PLAT


Location -----

Rig up -----

Drilling and Remarks:

*Rig Sldg.*

RECORD

Cased ----- in., ----- ft.

Sand -----

Gas -----

Oil -----

Total Depth -----

PRODUCTION

1st 24 hrs. Nat. -----

1st 24 hrs. after shot. -----

Gas ----- Cu. Ft.

Dry Hole -----

Abandoned -----

Date

3/1

1925

M. A. BENEAR

Scout

Map No. 2 Khan Sec. 13 Twp. 32 R. 4

Well No. 2 Roclawell

Mulvan & Neely Company

Contractor

COMPLETED

SECTION PLAT

Ft. from N. Line

300 Ft. from S. Line

Ft. from E. Line

1020 Ft. from W. Line

		6	

Location

Rig up

Drilling and Remarks:

200 lbs natural.

RECORD

Cased 7568-75 in., ft.

Sand 7568-75

Gas

Oil 7569-77

Total Depth 7577

PRODUCTION

1st 24 hrs. Nat. \_\_\_\_\_

1st 24 hrs. after shot \_\_\_\_\_

Gas \_\_\_\_\_ Cu. Ft.

Dry Hole \_\_\_\_\_

Abandoned \_\_\_\_\_

Date

APR 24 1925

192

Chas. L. Shover Scout