

Map No. **KANSAS** Sec. 22 Twp. 27 R. 5

Well No. 10 - Granston Farm


Empire O&K Company

..... Ft. from N. Line

330 Ft. from S. Line

990 Ft. from E. Line

..... Ft. from W. Line

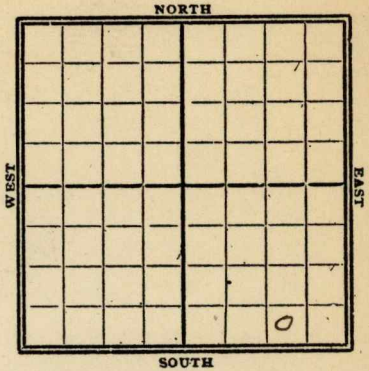

1929

Date

REPORT

6/12	Location
6/19	Bldg Key
6/26	Spdy 1700'
7/2	Drly 850'
7/10	" 1700'
7/17	" 2305'
7/24	" 2650'
7/31	sand 2731-66
	TD 2766
	shot 80 yds
	275 bbl oil
	Comp.

Butler

Map No. **KANSAS** Sec. 22 Twp. 27 R. 5

Well No. 10 Cranston

Empire Oil Co Company

Contractor

FIRST REPORTS

SECTION PLAT

.....Ft. from N. Line

330 Ft. from S. Line

990 Ft. from E. Line

.....Ft. from W. Line

			0

Location..... ✓

Rig up.....

Drilling and Remarks:

RECORD

Cased..... in., ft.
 Sand.....
 Gas.....
 Oil.....
 Total Depth.....

PRODUCTION

1st 24 hrs. Nat.....
 1st 24 hrs. after shot.....
 Gas..... Cu. Ft.
 Dry Hole.....
 Abandoned.....

Date

JUN 12 1929

192..... Scout

CHAS. L. SHERWOOD

Butler

Map No. **SAS** Sec. 22 Twp. 27 R. 5

Well No. 10 Cranston

Empire O&R Company

Contractor

COMPLETE

SECTION PLAT

_____ Ft. from N. Line

330 Ft. from S. Line

990 Ft. from E. Line

_____ Ft. from W. Line

			0

Location _____

Rig up _____

Drilling and Remarks:

80/275 lbs.

RECORD

Cased _____ in., _____ ft.

Sand 2731-2766

Gas _____

Oil _____

Total Depth 2766

PRODUCTION

1st 24 hrs. Nat. _____

1st 24 hrs. after shot _____

Gas _____ Cu. Ft.

Dry Hole _____

Abandoned _____

Date

JUL 31 1929

CHAS. L. SHERWOOD