


*Cowley*  
32 R. 4E

Map No. **KANSAS** Sec. *13* Twp. *32* R. *4E*

Well No. *3 Bishop Gallop & Bus* Farm \_\_\_\_\_ Company \_\_\_\_\_

NORTH

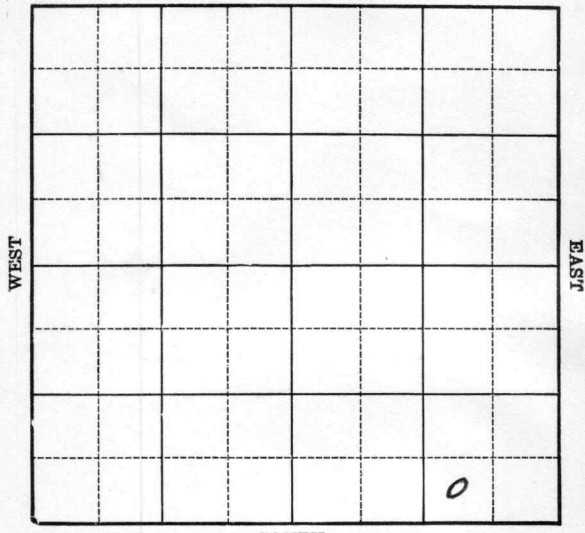

SOUTH

Location \_\_\_\_\_

Drilling Remarks \_\_\_\_\_

\_\_\_\_\_

\_\_\_\_\_

**RECORD**

Cased \_\_\_\_\_ in. \_\_\_\_\_ ft.

Sand \_\_\_\_\_

Gas \_\_\_\_\_

Oil \_\_\_\_\_

Total Depth \_\_\_\_\_

Rig Up \_\_\_\_\_

Drilling Remarks \_\_\_\_\_

\_\_\_\_\_

\_\_\_\_\_

**PRODUCTION**

1st 24 hrs. Nat. \_\_\_\_\_

1st 24 hrs. after shot \_\_\_\_\_

Gas \_\_\_\_\_ cu. ft. \_\_\_\_\_

Dry Hole \_\_\_\_\_

Abandoned \_\_\_\_\_

Cowley  
4E

Map No. KANSAS Sec. 13 Twp. 32 R. 4E


Well No. 3 Bishop Farm  
Gallop & Bess Company

\_\_\_\_\_ Ft. from N. Line

330 Ft. from S. Line

990 Ft. from E. Line

\_\_\_\_\_ Ft. from W. Line

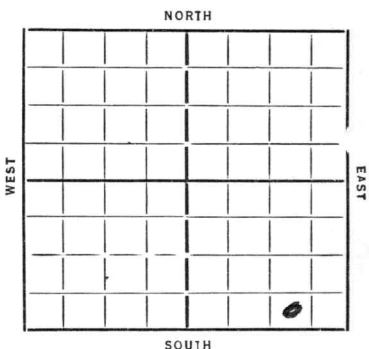

Date	REPORT	
1935		
1/30	Cellar	
2/7	Rign	
2/14	<del>2/21</del>	
2/28	Dlg 350	
3/7	" 825	
3/14	" 1300	
3/21		
3/28	Dlg 1595	8" 1564
4/4	" 1650	8" 1584
4/11		
4/18	57 1650	
4/26		
5/2	57 1780	
5/9	— 5/14 — 5/23 — 5/29 — 6/6 —	
6/13	— 6/20 — 6/28 — 7/3 — 7/11 —	
7/18	— 8/8 — 8/15 — 8/22 — 8/29 —	
9/6	— 10/3 — 10/10 —	
11/1	8" 1710 TD 2125 Runge	
11/7	Oil 2330	
11/14	TD 2342 that 59 ft flowed 220/24 hr.	
11/21	— 11/29 —	(OUGA)

12/4 Oil 2330  
TD 2342  
50 gts 120 Blk.

COMPLETED

Map No. 7 Sec. 13 Twp. 32 R. 4E

Well No. 3-Bishop

Grallay + Bess Company

Contractor

FIRST REPORTS

SECTION PLAT

Ft. from N. Line

330 Ft. from S. Line

990 Ft. from E. Line

Ft. from W. Line

			0

Location

Rig up

Drilling and Remarks:

cellar

RECORD\*

Cased.....in., .....ft.

Sand.....

Gas.....

Oil.....

Total Depth.....

PRODUCTION

1st 24 hrs. Nat.....

1st 24 hrs. after shot.....

Gas.....Cu. Ft.

Dry Hole.....

Abandoned.....

Date

1-30-35 192

ORVAL MANNSCHRECK Scout

Map No. 2 Sec. 13 Twp. 32 R. 4E

Well No. 3-Bishop

Grallops & Bess Company

Contractor

COMPLETE

SECTION PLAT

.....Ft. from N. Line

330 Ft. from S. Line

990 Ft. from E. Line

.....Ft. from W. Line

			0

Location.....

Rig up.....

Drilling and Remarks:

50 gts

120 bbls

RECORD

Cased.....in., .....ft.

Sand.....

Gas.....

Oil 2330

Total Depth 2342

PRODUCTION

1st 24 hrs. Nat.....

1st 24 hrs. after shot.....

Gas.....Cu. Ft.

Dry Hole.....

Abandoned.....

Date

12-4-35 192

ORVAL MANNSCHRECK Scout