


BUTLER

KANSAS

DX 78-1

Section 22 Township 27S Range 5E  
Well No. #70 Haverhill Unit  
Company Cities Service Oil

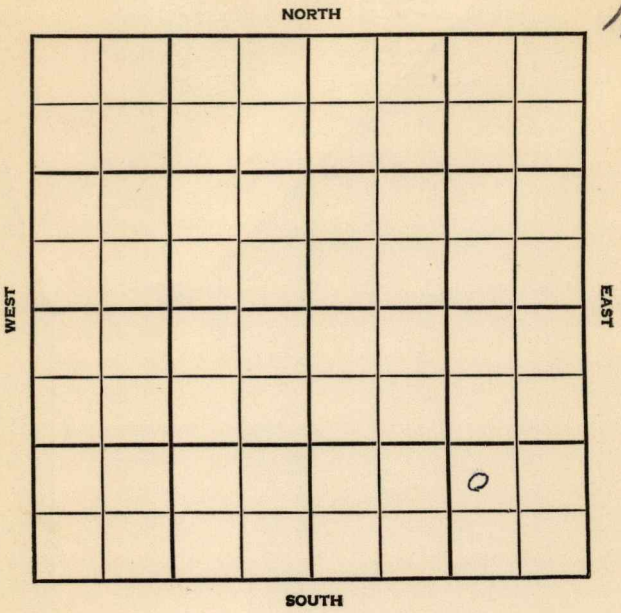


SEC. 22	TWP. 27S	R. 5E
------------	-------------	----------

WELL NO. 70 Haverhill Unit FARM

COMPANY  
Cities Service Oil

CONTRACTOR  
Haverhill

\_\_\_\_\_ FT. FROM N. LINE  
 \_\_\_\_\_ FT. FROM S. LINE  
 \_\_\_\_\_ FT. FROM E. LINE  
 \_\_\_\_\_ FT. FROM W. LINE

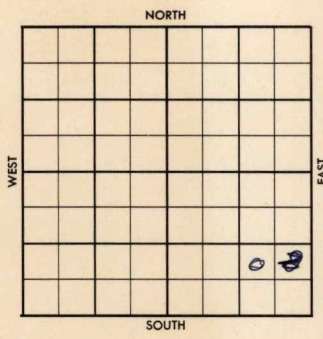

NW SE SE 880' FSL  
 830' FEL of SE/4

1956	ELEVATION 1346 RB	REPORT
------	----------------------	--------

6-20 10" @ 144 w/125  
 RTD 2773'  
 7" @ 2745'  
 CO 2773  
 pmp 9 bo / 59 bw, 22 hrs.  
 PB 2765,  
 Frac  
 pmp 25 bo / 245 bw , 24 hrs.  
 Completed  
 L. 1867', K.C. 2182', B.K.C. 2392',  
 Ce. 2597', Btv. 2737'

6-27 COMPLETE  
 TD 2773'

**COMPLETED**

29

Co.

County Butler Elev. 1346 RB  
 Sec. 22 Twp. 27S Rge. 5E 1354D7  
 Company Cities Service Oil  
 Farm Name Haverhill Unit No. 70

TOPS	DEPTH	LOG	DATUM	Loc. in Sec.
Anh.				NW SE SE
TP.				
H.				880' FSL
Tr.				830' FEL of
Dg.				SE <sub>4</sub>
Bl.				
L.	1867			
K.C.	2182			Geol.
B.K.C.	2392			Contr.
Ce.	2597			
C. <u>BTV</u>	2737			
M.				
M.				Pool
K.				<u>Haverhill</u>
Mz.				
Mq.				
V.				
S.				COMPLETE
S.				
A.				
R.				
PE.				
G.				
TD.	2773			

Use.

No.

Sec.

T.

R.

Date Comm. JUN 27 '56  
 10" 144 w/125; RTD 2773; 7" 2745; CO 2773  
 pmp 9 bo + 59 bw 22 hrs.; PB 2765;  
 frac; pmp 25 bo + 245 bw 24 hrs. JUN 27 '56  
complete  
 &

County Butler Elev. 1346 RB

Sec. 22 Twp. 27S Rge. 5E

Company Cities Service Oil

Farm Name Haverhill Unit No. 70

TOPS	DEPTH	LOG	DATUM	Loc. in Sec.																												
Anh.				NW SE SE																												
TP.				880' FSL																												
H.				830' FEL of																												
Tr.				SE <sub>4</sub>																												
Dg.																																
Bl.																																
L.	1867			Geol.																												
K.C.	2182			Contr.																												
B.K.C.	2392																															
Ce.	2397																															
C. <u>Btv</u>	2737			Pool																												
M.				<u>Haverhill</u>																												
M.				<table border="1"> <tr> <td colspan="2" rowspan="2">FIRST REPORT</td> <td rowspan="2">to</td> </tr> <tr> <td></td> </tr> <tr> <td></td> <td></td> <td></td> </tr> <tr> <td></td> <td></td> <td></td> </tr> <tr> <td></td> <td></td> <td></td> </tr> <tr> <td></td> <td></td> <td></td> </tr> <tr> <td></td> <td></td> <td></td> </tr> <tr> <td></td> <td></td> <td></td> </tr> <tr> <td></td> <td></td> <td></td> </tr> <tr> <td></td> <td></td> <td></td> </tr> </table>	FIRST REPORT		to																									
FIRST REPORT		to																														
K.																																
Mz.																																
Me.																																
V.																																
S.																																
S.																																
A.																																
R.																																
PE.																																
G.																																
T.D.																																

Date Comm. JUN 20 '56

10" 144 w/125; RTD 2773; 7" 2745; CO 2773  
 pmp 9 bo \* 59 bw 22 hrs.; PB 2765;  
 frac; pmp 25 bo + 245 bw 24 hrs.

JUN 22 1956

*29*

*[Signature]*

Co.  
L. Sec.  
No.  
Sec.  
T.  
R.