

Sec. 13 Twp. 32 R. 4E

Well No. #1 Cook Farm

McKnabb et al Company

Misc.


 Ft. from N. Line

990 Ft. from S. Line

~~990~~ Ft. from E. Line

990' Ft. from W. Line

NE SW SE
~~NW SE SE~~

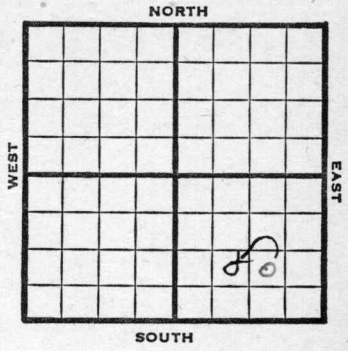

1947 Elev. 1230' REPORT

- 10/15 Drlg. 150'
- 10/22 Drlg. 400'
- 10/29 15" @ 323'
Drlg. 1405'
- 11/5 Drlg. 1514'
- 11/12 1525' UReam
- 11/19 SD
- 11/25 10" @ 1545'
Drlg. 1980'
- 12/3 8" @ 1870'
Drlg. 2130'
- 12/10 TD 2340-1400' oil
- 12/17 6" @ 2335'
- 12/30 "
- 1948
1/7 "
- 1/14 "

OVER

1948

1/21

Layton 2323'

6" @ 2335'

Pump 38 Pot

40.0 Gr.

TD 2347'

e

COMPLETED

Map No. _____ Sec. 13 Twp. 32 R. 4E

Well No. 1 Cook

McKnabb etal. Company

FIRST REPORT

Contractor

NW SE SE

SECTION PLAT

			o

_____ Ft. from N. Line

990 Ft. from S. Line

990 Ft. from E. Line

_____ Ft. from W. Line

Cowley County

Location _____

Rig up _____

Drilling and Remarks:

drlg. 150

RECORD

Cased _____ in., _____ ft.

Sand _____

Gas _____

Oil _____

Total Depth _____

PRODUCTION

1st 24 hrs. Nat. _____

1st 24 hrs. after shot _____

Gas _____ Cu. Ft.

Dry Hole _____

Abandoned _____

Date

OCT 15 1947

19

S. J. LEWIS

Scout

Kansas

Map No. 21 Sec. 13 Twp. 32 R. 4E

Well No. 1 Cook

McKnabb et al. Company

COMPLETE

Contractor

NE SW SE

21/280

SECTION PLAT

Ft. from N. Line

990 Ft. from S. Line

Ft. from E. Line

990 Ft. from W. Line

Cowley County

RECORD

Location _____

Cased _____ in., _____ ft.

Rig up _____

Sand _____

Drilling and Remarks:

Gas _____

Layton 2323

Oil

6" @ 2335

Total Depth 2847

Pump 35 ft

PRODUCTION

1st 24 hrs. Nat. _____

1st 24 hrs. after shot _____

Gas _____ Cu. Ft.

Dry Hole _____

Abandoned _____

40 2/3

Date

JAN 21 1948

19

S. J. LEWIS

Scout

Please check your tickets before mailing into this office. This causes a lot of trouble to other departments who put them on thier maps and then scratch them off.

Sam

SECTION PLAT

RECORD

Misc. Small Maps

Cards

Tracing

France Map

Scarborough Map

Pierce Map

Geological Dept.

Pierce Plat Book