


Cowley 4E

Map No. _____ Sec. 13 Twp. 32 R. _____

Well No. 1-Cook
Gralapp et al Farm
Company

NORTH

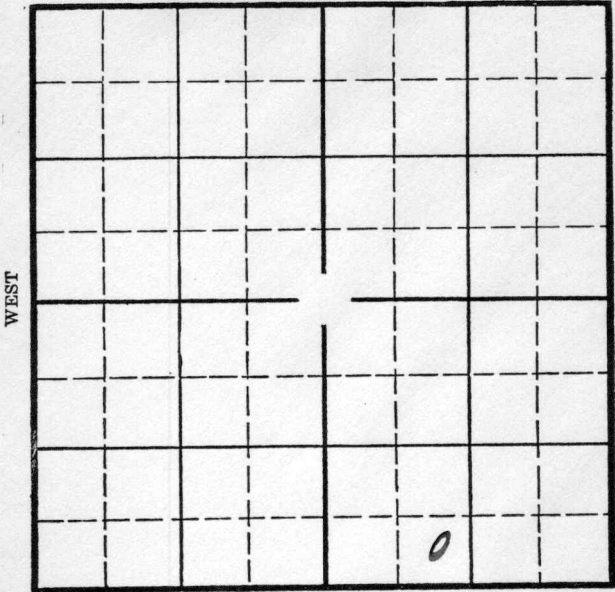

SOUTH

Location _____

Drilling Remarks _____

Rig Up _____

Drilling Remarks _____

RECORD

Cased _____ in. _____ ft.

Sand _____

Gas _____

Oil _____

Total Depth _____

PRODUCTION

1st 24 hrs. Nat. _____

1st 24 hrs. after shot _____

Gas _____ cu. ft.

Dry Hole _____


Abandoned _____

Cowley

Map No. _____ Sec. 13 Twp. 32 R. 4E

Well No. 1-Cook Farm _____
Thalapp et al Company _____

_____ Ft. from N. Line
330 Ft. from S. Line
_____ Ft. from E. Line
990 Ft. from W. Line

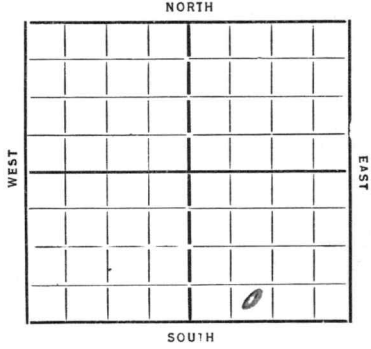

Elev. 1231

Date	REPORT
11/6	Cellar
11/14	Mg Rig
11/21	Rig
11/29	—
12/6	Spud 300
12/13	Wdy 1275 12" 393
12/19	" 1690
12/26	—
1/2/36	Top Peru sh 2500
1/8	75 gts 2320-55 Est 200 lbs.
	Peru 2300
	TD 2355
	75 gts 200 Oil
	COMPLETED

Map No. 2 Sec. 13 Twp. 32 R. 4E

Well No. 1-Cook

Gralayp ital Company

Contractor

FIRST REPORTS

SECTION PLAT

.....Ft. from N. Line

330 Ft. from S. Line

.....Ft. from E. Line

990 Ft. from W. Line

Location.....

Rig up.....

Drilling and Remarks:

Clear

RECORD

Cased.....in.,ft.

Sand.....

Gas.....

Oil.....

Total Depth.....

PRODUCTION

1st 24 hrs. Nat.....

1st 24 hrs. after shot.....

Gas.....Cu. Ft.

Dry Hole.....

Abandoned.....

Date

ORVAL MANN SCHRECK

11-6-35 192.....

Scout

Cowley
Form 26-1M Bks. 9-28

KANSAS

Map No. 2 Sec. 13 Twp. 32 R. 4E

Well No. 1 - Cook

Gallop Company

Contractor

SECTION PLAT

.....Ft. from N. Line

330 Ft. from S. Line

.....Ft. from E. Line

990 Ft. from W. Line

COMPLETED

Location.....

Rig up.....

Drilling and Remarks:

75 gts

200 oil

RECORD

Cased..... in., ft.

Sand *Peru* 2300

Gas.....

Oil.....

Total Depth..... 2355

PRODUCTION

1st 24 hrs. Nat.....

1st 24 hrs. after shot.....

Gas..... Cu. Ft.

Dry Hole.....

Abandoned.....

Date

JAN 8 1936 192.....

ORVAL MANNSCHRECK
Scout