


Map No. Kans Sec. 13 Twp. 32 R. 4

Well No. 2 Cook Farm

Gypsy oil Company

NORTH

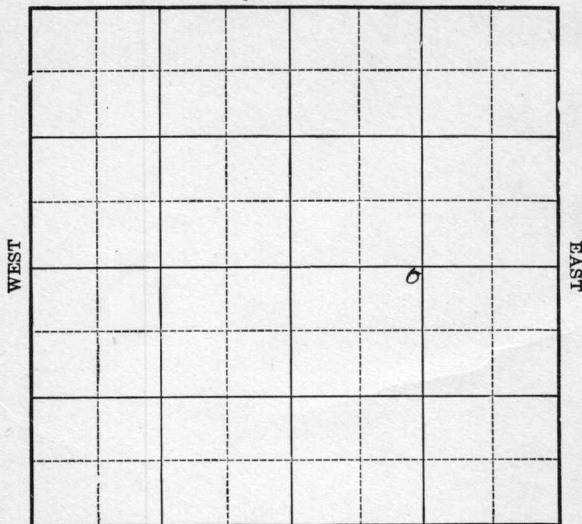

Location \_\_\_\_\_

Drilling Remarks \_\_\_\_\_

Rig Up \_\_\_\_\_

Drilling Remarks \_\_\_\_\_

**RECORD**

Cased \_\_\_\_\_ in. \_\_\_\_\_ ft.

Sand \_\_\_\_\_

Gas \_\_\_\_\_

Oil \_\_\_\_\_

Total Depth \_\_\_\_\_

**PRODUCTION**

1st 24 hrs. Nat. \_\_\_\_\_

1st. 24 hrs. after shot \_\_\_\_\_

Gas \_\_\_\_\_ cu. ft.

Dry Hole \_\_\_\_\_

Abandoned \_\_\_\_\_



Map No. 2 **KANSAS** Sec. 13 Twp. 32 R. 4

Well No. # 2 (Ook)

Geysey Company

Contractor

# FIRST REPORT

# SECTION PLAT

300 Ft. from N. Line

----- Ft. from S. Line

----- Ft. from E. Line

300 Ft. from W. Line

		0	

Location -----

Rig up -----

Drilling and Remarks:

*Timber*

## RECORD

Cased ----- in., ----- ft.

Sand -----

Gas -----

Oil -----

Total Depth -----

## PRODUCTION

1st 24 hrs. Nat. -----

1st 24 hrs. after shot -----

Gas ----- Cu. Ft.

Dry Hole -----

Abandoned -----

Date

2/8 1925

M. A. BENEAR

Scout

Map No. 2 Kansas Sec. 13 Twp. 32 R. 4

Well No. 2 Cook

Gypsy Oil Company

Contractor

SECTION PLAT

300 Ft. from N. Line

\_\_\_\_\_ Ft. from S. Line

\_\_\_\_\_ Ft. from E. Line

1070 Ft. from W. Line


Location \_\_\_\_\_

Rig up \_\_\_\_\_

Drilling and Remarks:

Correction

RECORD

Cased \_\_\_\_\_ in., \_\_\_\_\_ ft.

Sand \_\_\_\_\_

Gas \_\_\_\_\_

Oil \_\_\_\_\_

Total Depth \_\_\_\_\_

PRODUCTION

1st 24 hrs. Nat. \_\_\_\_\_

1st 24 hrs. after shot \_\_\_\_\_

Gas \_\_\_\_\_ Cu. Ft.

Dry Hole \_\_\_\_\_

Abandoned \_\_\_\_\_

Date \_\_\_\_\_

4/1 1925

MAR Scout

Map No. 1544 Sec. 13 Twp. 32 R. 4

Well No. 2

Coolidge Company

Byrnes Oil Co. Contractor

COMPLETED

SECTION PLAT

300 Ft. from N. Line

----- Ft. from S. Line

----- Ft. from E. Line

1070 Ft. from W. Line

		○	

ABANDONED

Location -----

Rig up -----

Drilling and Remarks:

Show on 2570-75'  
 Top line 3050'  
 #7 3465-3500'  
 TD 3580'  
 My 2 aband

RECORD

Cased ----- in., ----- ft.

Sand -----

Gas -----

Oil -----

Total Depth 3580'

PRODUCTION

1st 24 hrs. Nat. -----

1st 24 hrs. after shot -----

Gas ----- Cu. Ft.

Dry Hole  -----

Abandoned  -----

Date

MAY 29 1925

192

CHAS. L. SHERWOOD  
 Scout

*Cowley*

MAP NO. K2 KANSAS SEC. 13 TWP. 32S R. 1E

WELL No. ✓ Cook

Gypsy COMPANY  
CONTRACTOR

**SECTION PLAT**

ABANDONED

		0	

\_\_\_\_\_ FT. FROM N. LINE  
\_\_\_\_\_ FT. FROM S. LINE  
\_\_\_\_\_ FT. FROM E. LINE  
\_\_\_\_\_ FT. FROM W. LINE

**RECORD**

LOCATION \_\_\_\_\_  
RIG UP \_\_\_\_\_  
DRILLING AND REMARKS:

CASED \_\_\_\_\_ IN., \_\_\_\_\_ FT.  
SAND \_\_\_\_\_  
GAS \_\_\_\_\_  
OIL \_\_\_\_\_  
TOTAL DEPTH 3280

**PRODUCTION**

1ST 24 HRS. NAT. \_\_\_\_\_  
1ST 24 HRS. AFTER SHOT \_\_\_\_\_  
GAS \_\_\_\_\_ CU. FT.  
DRY HOLE ✓  
ABANDONED ✓

DATE 6-1 1925 SCOUT