


Section 13 Township 32 Range 4E

Well No. #1 McIntyre

Company H.H. Blair

NORTH

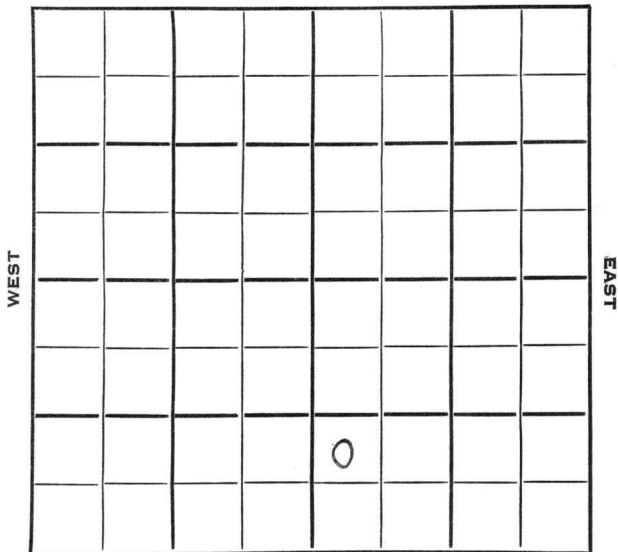

SOUTH

Cowley

KANSAS

SEC.	13	TWP.	32	R.	4E
------	----	------	----	----	----


WELL NO. #1 McIntyre FARM

COMPANY H.H. Blair

CONTRACTOR

Winfield Pool

_____ Ft. from N. Line
 990 _____ Ft. from S. Line
 _____ Ft. from E. Line
 430 _____ Ft. from W. Line

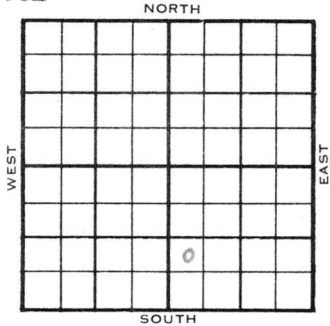

NW SW SE

	ELEVATION	REPORT
1953	1229'	
10/7	M I CT	
12/30	Spud 10-13-53 D&A TD 3036' 15" @ 389' 13" @ 865' 10" @ 1760' 8" @ 2160' Layton 2324', KC 2500, 7" @ 2531 Bart 3021 TD 3036' D&A	
		ABANDONED

