


Map No. *KANSAS* Sec. *27* Twp. *13* R. *15W*
 Well No. *1- Miller* Farm
Hartman & Blair Company

NORTH

WEST

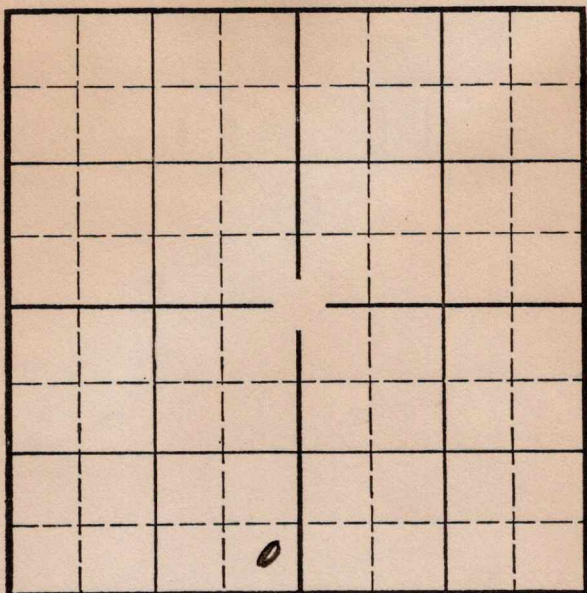

EAST

SOUTH

Location

Drilling Remarks

Rig Up

Drilling Remarks

RECORD

Cased in ft.

Sand

Gas

Oil

Total Depth

PRODUCTION

1st 24 hrs. Nat.

1st 24 hrs. after shot

Gas cu. ft.

Dry Hole


Abandoned

Russell

Map No. KANSAS Sec. 27 Twp. 13 R. 15W

Well No. 1-Miller Farm
Hartman & Blair Company

 Ft. from N. Line
330 Ft. from S. Line
330 Ft. from E. Line
 Ft. from W. Line

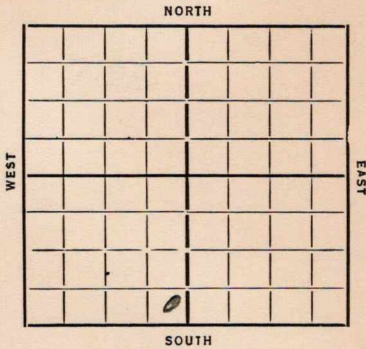

Elev. 1921

Date	REPORT
1935	
6/5	Location
6/13	6/20 — 6/28
7/3	B.R. 15" 361
7/11	Rig 18 1/2" 605
7/18	10" 965
8/8	Alg 1085 An 960
8/15	" 2020
8/22	8" 2484
8/29	8" 2573 Top 2795
9/6	Alg 2930
9/20	RC 3110 WB 6" 3140
	Sil 3380
	TJ 3387
	70 ft.

ABANDONED

Map No. 72 Sec. 27 Twp. 13 R. 15Well No. 1-MillsHartman & Blair Company

Contractor

FIRST REPORTS

SECTION PLAT

Ft. from N. Line

330 Ft. from S. Line330 Ft. from E. Line

Ft. from W. Line

Location ✓Rig up ✓

Drilling and Remarks:

RECORD

Cased _____ in., _____ ft.

Sand _____

Gas _____

Oil _____

Total Depth _____

PRODUCTION

1st 24 hrs. Nat. _____

1st 24 hrs. after shot _____

Gas _____ Cu. Ft.

Dry Hole _____

Abandoned _____

Date

6-5-35

192

Scout

ORVAL MANN SCHRECK

Map No. 72 Sec. 27 Twp. 13 R. 15

Well No. 1-Mills

Hartman & Blair Company

Contractor

ABANDONED

KANSAS

SECTION PLAT

Ft. from N. Line

330 Ft. from S. Line

330 Ft. from E. Line

Ft. from W. Line

Location

Rig up

Drilling and Remarks:

DTF

RECORD

Cased in. ft.

Sand Sil 3380

Gas

Oil

Total Depth 3387

PRODUCTION

1st 24 hrs. Nat.

1st 24 hrs. after shot

Gas Cu. Ft.

Dry Hole

Abandoned

ORVAL MANNSCHRECK

Date

9-20-35

Scout