


Cowley

(152) Map No. *TANS* Sec. *13* Twp. *32* R. *4*

Well No. *5* *Rockwell* Farm

Marland Oil Company

NORTH

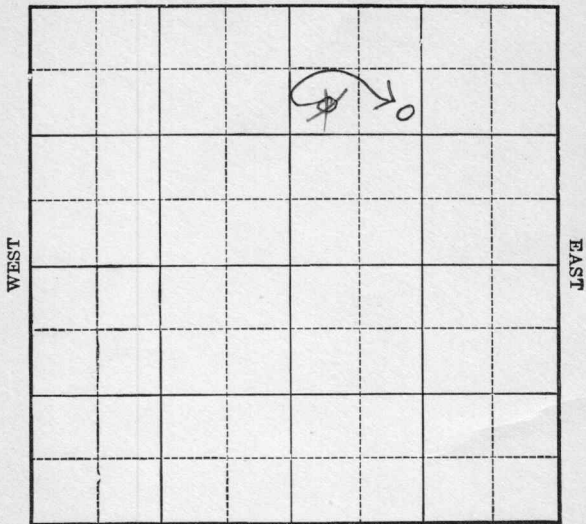

SOUTH

Location _____

Drilling Remarks _____

Rig Up _____

Drilling Remarks _____

RECORD

Cased _____ in. _____ ft.

Sand _____

Gas _____

Oil _____

Total Depth _____

PRODUCTION

1st 24 hrs. Nat. _____

1st 24 hrs. after shot _____

Gas _____ cu. ft.

Dry Hole _____

Abandoned _____

Cowley

Map No. Kansas Sec. 15 Twp. 32 R. 4

Well No. 5 Rockwell Farm


Marland Oil Company

990 Ft. from N. Line

_____ Ft. from S. Line

_____ Ft. from E. Line

990
~~330~~
~~220~~ Ft. from W. Line

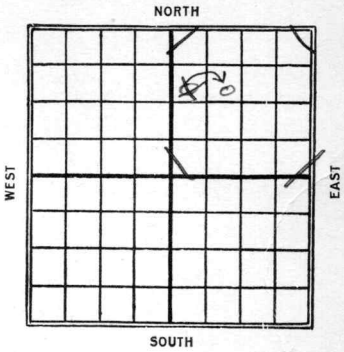

Date	REPORT
1936	
6/30	R. O. G.
7/8	Bldg rig
7/15	Rigging up
7/22	Spudding
7/28	Bldg 450
8/4	" 1140
8/11	" 1640
8/18	" 1905
8/25	" 2125
8/31	" 2160
9/5	sand 2598-2603
	water & show oil - Drlg.
9/22	Drlg 2865
9/29	sand 3012-24
	Drlg 3040
10/13	Dry sand 3012-24'
	S.R. 6" 3126'
10/27	WR. 6" 3140'
11/11	same
11/17	_____
11/23	Drlg 3335'
12/8	_____

12/15 - Plugged back to 2605'
cleaning out.
12/22 - same
12/30 - sand 2598-2603
I.D. 3335' - P.B.
to 2605'
5/20 bbls

Cowley

K2 KANSAS Map No. _____ Sec. *13* Twp. *32* R. *4*

Well No. *5* _____

Marland Oil Co _____ Company

_____ Contractor

FIRST REPORTS

SECTION PLAT

990 Ft. from N. Line

_____ Ft. from S. Line

_____ Ft. from E. Line

330 Ft. from W. Line

		o	

Location _____

Rig up _____

Drilling and Remarks:

Rozy

RECORD

Cased _____ in., _____ ft.

Sand _____

Gas _____

Oil _____

Total Depth _____

PRODUCTION

1st 24 hrs. Nat. _____

1st 24 hrs. after shot _____

Gas _____ Cu. Ft.

Dry Hole _____

Abandoned _____

Date

JUN 30 1926

192

CHAS. L. SHERWOOD

Scout

Cowley

Map No. K2 KANSAS Sec. 13 Twp. 32 R. 4

Well No. 5 Rockwell
Murkand Oil Co. Company

Contractor

CORRECTION

990 Ft. from N. Line
Ft. from S. Line
Ft. from E. Line
990 Ft. from W. Line

SECTION PLAT

		o	

RECORD

Location _____
Rig up _____
Drilling and Remarks:

Cased _____ in., _____ ft.
Sand _____
Gas _____
Oil _____
Total Depth _____

Only 450'
by loc to
show

PRODUCTION

1st 24 hrs. Nat. _____
1st 24 hrs. after shot _____
Gas _____ Cu. Ft.
Dry Hole _____
Abandoned _____

Date
JUL 28 1926

CHAS. L. SHERWOOD

Cowley

2 KANSAS Map No. Sec. 13 Twp. 32 R. 4

Well No. 5

Marlane Oil Co. Company

Contractor

COMPLETED

SECTION PLAT

990 Ft. from N. Line

Ft. from S. Line

Ft. from E. Line

990 Ft. from W. Line

		o	

Location

Rig up

Drilling and Remarks:

Plugged Back to 2605 5/20 lbs.

RECORD

Cased in. ft.

Sand 2598-2603

Gas

Oil

Total Depth 3335

PRODUCTION

1st 24 hrs. Nat.

1st 24 hrs. after shot

Gas Cu. Ft.

Dry Hole

Abandoned

Date DEC 30 1926

CHAS. L. SHERWOOD