


Section 15 Township 32 Range 4E

Well No. 1 Graham

Company K. T. Weidemann

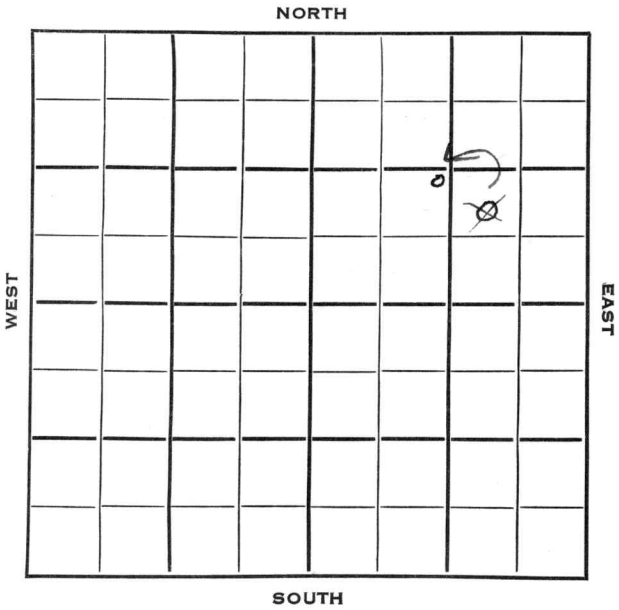

Cowley

KANSAS ✓

Sec. 15 Twp. 32 R. 4E

Well No. 1 Graham Farm

K. T. Weidemann Company

Contractor


Ft. from N. Line

1090 Ft. from S. Line

~~1090~~ Ft. from E. Line

1090 Ft. from W. Line

~~NE SW NE~~
~~NW SE NE~~

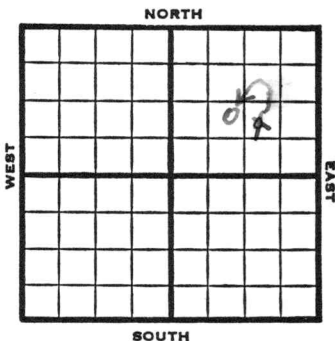

1952 Elev. 1154 REPORT

12/30 10" @ 92
 3/25 Spud 12-25-52
 D & A
 TD 2337
 10" @ 92
 Layton 2264, Layton sd. 2309,
 TD 2319
 5" @ 2314
 DD 2337
 PB 2332
 D & A

ABANDONED

County **Cowley** State **Kansas**

Sec. **15** (Blk. Twp.) **32** (Sur. Rge.) **4E** Map No.

Operator **K. T. Weidemann**

Well No. **1** Farm **Graham**

Elev. Location **NW SE NE**

1090 Ft. From **S** Line **NE**

1090 Ft. From **E** Line Quarter

1st. Report **DEC 30 1952**

Completion

Remarks

Spudding Date

Drlg. Data

10" @ 92

Kansas

Map No. _____ Sec. 15 Twp. 32 R. 4E

Well No. 1 Graham

K. T. Weidemann Company

CORRECTIONS Contractor

NE SW NE

SECTION PLAT

_____ Ft. from N. Line

1090 Ft. from S. Line

_____ Ft. from E. Line

1090 Ft. from W. Line

		o	

Cowley County

Location _____

Rig up _____

Drilling and Remarks:

Reported

NW SE NE

RECORD

Cased _____ in., _____ ft.

Sand _____

Gas _____

Oil _____

Total Depth _____

PRODUCTION

1st 24 hrs. Nat. _____

1st 24 hrs. after shot _____

Gas _____ Cu. Ft.

Dry Hole _____

Abandoned _____

Date

JAN 21 1953 19

J. G. McGEHEE

Scout

