



*Cowley*

Map No. *15* Sec. *15* Twp. *32* R. *4*


Well No. *1-Graham* Farm  
*McMahon Oil* Company

*990* Ft. from N. Line

..... Ft. from S. Line

..... Ft. from E. Line

*990* Ft. from W. Line

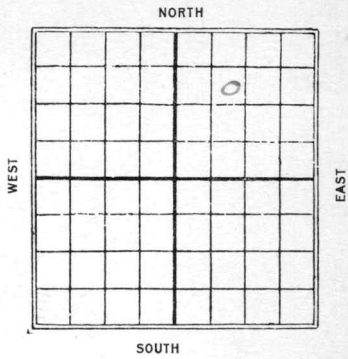

*1926*

Date

REPORT

<i>12/2</i>	<i>Timbers</i>
<i>12/30</i>	<i>Rigging up</i>
<i>1927</i>	
<i>1/6</i>	<i>Same</i>
<i>1/13</i>	<i>Drilling 460</i>
<i>1/19</i>	<i>" 1050</i>
<i>1/26</i>	<i>" 1400</i>
<i>2/3</i>	<i>" 1593</i>
<i>2/9</i>	<i>" 1840</i>
<i>2/17</i>	<i>" 2255</i>
<i>2/24</i>	<i>" 2430</i>
<i>3/2</i>	<i>Top line 2962 running 6"</i> <i>2965</i>
<i>3/9</i>	<i>Drlg 3090</i>
<i>3/16</i>	<i>" 3200</i>
<i>3/24</i>	<i>Silicious line 3264-65 T.O.</i> <i>317 bbls. 1st 24 hrs. - 270 bbls.</i> <i>2nd. - 240 bbls 3rd 24 hrs.</i>
<i>3/30</i>	<i>Top line 2962</i> <i>Silc line 3264-67 1/2</i> <i>480 bbls</i>

*Cowley*

Map No. KANSAS Sec. 15 Twp. 32 R. 4

Well No. 1 *Stahom*

*Mc Mahon oil Co* Company

Contractor

FIRST REPORTS


SECTION PLAT

990 Ft. from N. Line

\_\_\_\_\_ Ft. from S. Line

\_\_\_\_\_ Ft. from E. Line

990 Ft. from W. Line

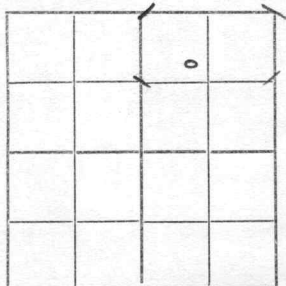

Location \_\_\_\_\_

Rig up *summers*

Drilling and Remarks:

RECORD

Cased \_\_\_\_\_ in., \_\_\_\_\_ ft.

Sand \_\_\_\_\_

Gas \_\_\_\_\_

Oil \_\_\_\_\_

Total Depth \_\_\_\_\_

PRODUCTION

1st 24 hrs. Nat. \_\_\_\_\_

1st 24 hrs. after shot \_\_\_\_\_

Gas \_\_\_\_\_ Cu. Ft.

Dry Hole \_\_\_\_\_

Abandoned \_\_\_\_\_

Date

DEC 22 1926

CHAS. L. SHERWOOD

192

Scout

*Cowley*

**2 KANSAS**

Map No. \_\_\_\_\_ Sec. *15* Twp. *32* R. *4*

Well No. *1 Graham*

*The McGowan Oil Co* Company

Contractor \_\_\_\_\_

**COMPLETED**

**SECTION PLAT**

*990* Ft. from N. Line

\_\_\_\_\_ Ft. from S. Line

\_\_\_\_\_ Ft. from E. Line

*990* Ft. from W. Line

		0	

Location \_\_\_\_\_

Rig up \_\_\_\_\_

Drilling and Remarks:

*Top line 2962*

*Side line 3264-67*

*480 Bls.*

**RECORD**

Cased \_\_\_\_\_ in., \_\_\_\_\_ ft.

Sand \_\_\_\_\_

Gas \_\_\_\_\_

Oil \_\_\_\_\_

Total Depth *3267 1/2*

**PRODUCTION**

1st 24 hrs. Nat. \_\_\_\_\_

1st 24 hrs. after shot \_\_\_\_\_

Gas \_\_\_\_\_ Cu. Ft.

Dry Hole \_\_\_\_\_

Abandoned \_\_\_\_\_

Date

**MAR 30 1927**

**CHAS. L. SHERWOOD**

**192**

Scout