


Section 28 Township 18S Range 10W

Well No. #2 Sittner

Company Sierra Petroleum

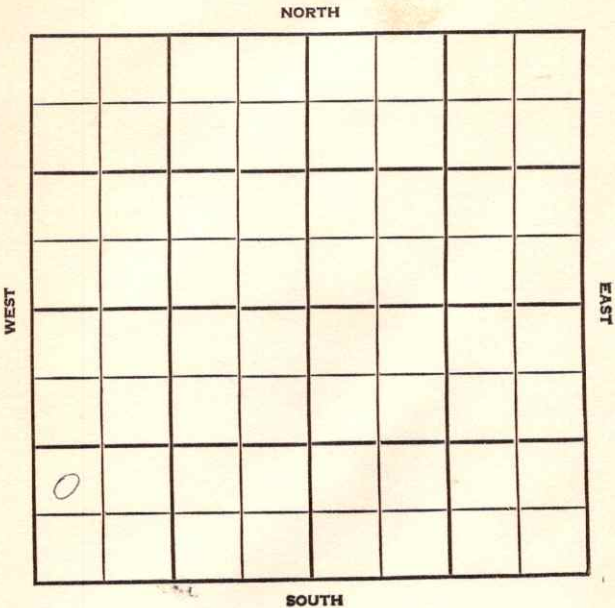

Rice

KANSAS

SEC.

28

TWP.

18

R.

10W

WELL NO.

#2 Sittner

FARM

COMPANY

Sierra Petroleum

CONTRACTOR

Co.

Ringwald

____ FT. FROM N. LINE

____ FT. FROM S. LINE

____ FT. FROM E. LINE

____ FT. FROM W. LINE

NW SW SW

NORTH

WEST

EAST

SOUTH

1956

ELEVATION

1737

REPORT

8-15 Loc.

9-5 Comm 8-20-56

H 2762

B1 2883

L 2902

A 3228

TD 3259

8 5/8" @ 196 w/120 WOC

DST 2987-99 1 hr rec 120' gas +

30' O & GCM 110/15"

DST 3246-59 45" rec

20' mud BHP 680/15

D & A

ABANDONED

Co.

County Rice Elev. 1737
 Sec. 28 Twp. 18S Rge. 10W
 Company Sierra Petroleum
 Farm Name Sittner No. 2

TOPS	DEPTH	LOG	DATUM	Loc. in Sec.
Anb.				1/4 SW SW
TP.				870 3/4
H.	2762			230 1/4
Tr.				
Dg.				
BL.	2883			
L.	2902			
K.C.				Geol.
B.K.C.				Contr. Co.
Ce.				
C.				
M.				Pool
M.				Ringwald
K.				
Mz.				
Ma.				
V.				
S.				
S.				
A.	3228			ABANDONED
R.				
PE.				
G.				
				0 SEP 5 '56
T.D.	3259			

Lse.

No.

Sec.

T.

R.

Date Comm.

Loc. AUG 22 '56 P-20-56 85/8 196
 1120 WOC AUG 29 '56 DST 2981-99
 1hr rec 120' gas + 30' oil 6CM
 110/15" DST 3246-59 45" rec
 20' Md BHP 680/15 SEP 5 '56

P&A

County Rice Elev. _____
 Sec. 28 Twp. 18S Rge. 10W
 Company Sierra Petroleum
 Farm Name Sittner No. 2

TOPS	DEPTH	LOG	DATUM	Loc. in Sec.
Anh.				NW SW SW
Tr.				
H.				
Tr.				
Dg.				
BL.				
L.				Geol. _____
K.C.				Contr. Co. _____
B.K.C.				
Ce.				
C.				
M.				Pool _____
M.				Ringwald
K.				
Mz.				
Me.				
V.				
S.				
S.				
A				
R.				
Pe.				
G.				
T.D.				



Date Comm.

AUG 15 '56

Loc.

8321 S S 211A

R.G.R.