


Map No. Kansas Sec. 14 Twp. 32 R. 4
Well No. 1 Griffith Farm
T. A. Hull Company

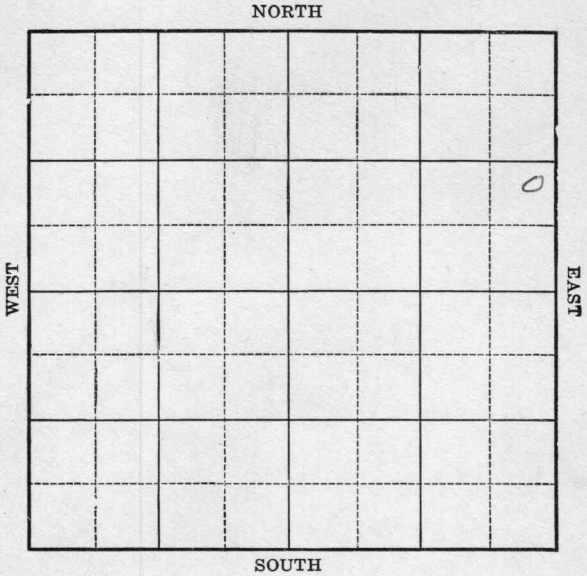

Location _____
Drilling Remarks _____

Rig Up _____
Drilling Remarks _____

RECORD

Cased _____ in. _____ ft.
Sand _____
Gas _____
Oil _____
Total Depth _____

PRODUCTION


1st 24 hrs. Nat. _____
1st. 24 hrs. after shot _____
Gas _____ cu. ft.
Dry Hole _____
Abandoned _____

Map No. Kansas Sec. 14 Twp. 32 R 4Well No. 1 Griffith FarmJ. A. Hull Company

Ft. from N. Line

1020 Ft. from S. Line300 Ft. from E. Line

Ft. from W. Line

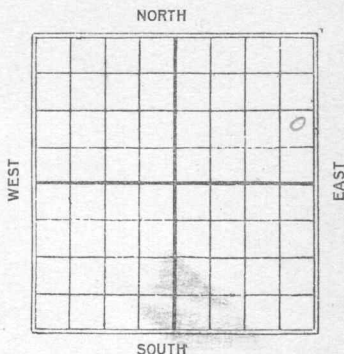

Date

REPORT

19253/1Rig Bldg5/29Daly 2900.6/5T.L. 3090 D+ Abd T.D. 3092

Map No. KANSAS Sec. 14 Twp. 32 R. 4Well No. #1 GriffithJ. A. Bull Company

Contractor

FIRST REPORT

----- Ft. from N. Line

1020 Ft. from S. Line300 Ft. from E. Line

----- Ft. from W. Line

SECTION PLAT

			0

Location -----

Rig up -----

Drilling and Remarks:

Rig bldg.

RECORD

Cased ----- in., ----- ft.

Sand -----

Gas -----

Oil -----

Total Depth -----

PRODUCTION

1st 24 hrs. Nat. -----

1st 24 hrs. after shot -----

Gas ----- Cu. Ft.

Dry Hole -----

Abandoned -----

Date

3/11925

M. A. BENEAR

Scout

MAP No. K2 KANSAS SEC. 14 TWP. 32S R. 4E

WELL No. 1 Shuffert

COMPANY

CONTRACTOR

SECTION PLAT

ABANDONED

_____ FT. FROM N. LINE

_____ FT. FROM S. LINE

_____ FT. FROM E. LINE

_____ FT. FROM W. LINE

RECORD

LOCATION _____

CASED _____ IN. _____ FT.

RIG UP _____

SAND _____

DRILLING AND REMARKS:

GAS _____

OIL _____

TOTAL DEPTH 3092

PRODUCTION

1ST 24 HRS. NAT. _____

1ST 24 HRS. AFTER SHOT _____

GAS _____ CU. FT.

DRY HOLE _____

ABANDONED _____

DATE

Apr 5 1925 SCOUT

Map No. 5442 Sec. 14 Twp. 32 R. 4Well No. 1 MoffittJ. W. Hull Company

Contractor

COMPLETED

SECTION PLAT

Ft. from N. Line

1020 Ft. from S. Line300 Ft. from E. Line

Ft. from W. Line

			0

ABANDONED

Location

Rig up

Drilling and Remarks:

Top line 3090'
dry & hole
20 3092'

RECORD

Cased _____ in., _____ ft.

Sand _____

Gas _____

Oil _____

Total Depth 3092

PRODUCTION

1st 24 hrs. Nat. _____

1st 24 hrs. after shot _____

Gas _____ Cu. Ft.

Dry Hole ☒Abandoned ☒

Date

JUN 5 1925

192

CHAS. L. SHERWOOD

Scout