



**KANSAS**

Sec. 25 Twp. 18 R. 10W

Well No. #2 Benhke Farm

Vickers Company

Bredfeldt

330 Ft. from N. Line


         Ft. from S. Line

330 Ft. from E. Line

         Ft. from W. Line

NE NW

*Elev. 1736*

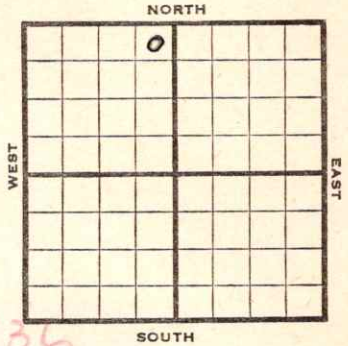

1945

R E P O R T

2/14 SH

2/21 Lans 2890  
Drlg 2929

2/28 Arb. 3248  
TD 3289

**ABANDONED**

Pool Name BredfeldtMap No. K-55 Sec. 25 Twp. 18 R. 10WWell No. 2 BenhkeVickers

Company

FIRST REPORT

Contractor

NE NW

## SECTION PLAT

	0		

330 Ft. from N. Line

\_\_\_\_\_ Ft. from S. Line

330 Ft. from E. Line

\_\_\_\_\_ Ft. from W. Line

Rice

Location \_\_\_\_\_

Rig up \_\_\_\_\_

Drilling and Remarks:

SH

## RECORD

Cased \_\_\_\_\_ in., \_\_\_\_\_ ft.

Sand \_\_\_\_\_

Gas \_\_\_\_\_

Oil \_\_\_\_\_

Total Depth \_\_\_\_\_

## PRODUCTION

1st 24 hrs. Nat. \_\_\_\_\_

1st 24 hrs. after shot \_\_\_\_\_

Gas \_\_\_\_\_ Cu. Ft.

Dry Hole \_\_\_\_\_

Abandoned \_\_\_\_\_


Date

FEB 14 1945 19

S. J. LEWIS Scout

Pool Name BredfeldtMap No. 55 Sec. 25 Twp. 18 R. 10WWell No. 2 BenhkeVickers CompanyABANDONED ContractorNE NW

## SECTION PLAT

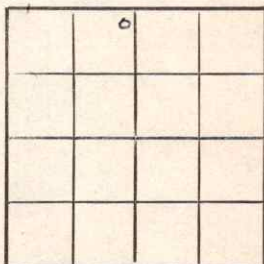330 Ft. from N. Line       Ft. from S. Line330 Ft. from E. Line       Ft. from W. LineRice County

Location \_\_\_\_\_

Rig up \_\_\_\_\_

Drilling and Remarks:

On 83248

## RECORD

Cased \_\_\_\_\_ in., \_\_\_\_\_ ft.

Sand \_\_\_\_\_

Gas \_\_\_\_\_

Oil \_\_\_\_\_

Total Depth 3289

## PRODUCTION

1st 24 hrs. Nat. \_\_\_\_\_

1st 24 hrs. after shot \_\_\_\_\_

Gas \_\_\_\_\_ Cu. Ft.

Dry Hole \_\_\_\_\_

Abandoned \_\_\_\_\_

Date

FEB 28 1945

19

S. J. LEWIS

Scout