


KANSAS
Cowley

Section 15 Township 32 Range 4E

Well No. 1 State _____

Company H H Blair

Misc.
NORTH

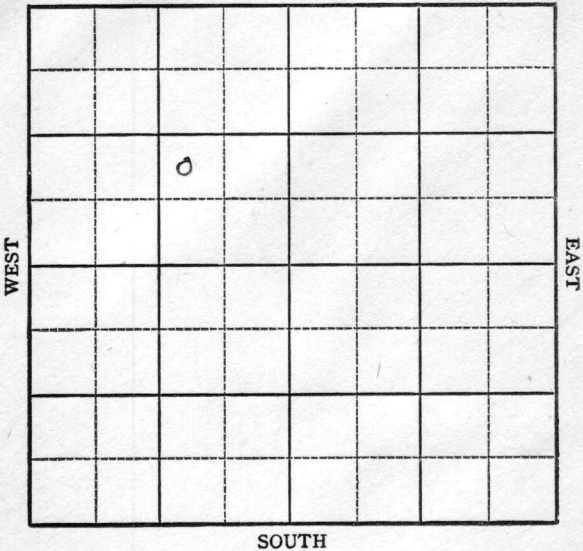

Sec. 15 Twp. 32 R. _____

Well No. #1 State Farm _____

H. H. Blair

Company _____

Miscellaneous


_____ Ft. from N. Line

990' Ft. from S. Line

990' Ft. from E. Line

_____ Ft. from W. Line

NW SE NW

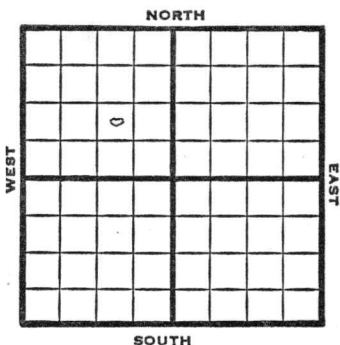

1948

Elev. 1143' REPORT

- 10/27 Machine
- 11/3 15" @ 162'
Drlg 850
- 11/10 10" @ 1459'
rlg 1585'
- 11/16 10" @ 1698'
Drlg. 1801'
- 11/23 10" @ 1810'
Drlg 1960'
- 11/30 8" @ 2246'
Layton 2303'
Drlg. 2345'
- 12/6 8" @ 2391'
Drlg. 2405'
- 12/14 Miss 2923'
6" @ 2923'
Drlg. 2930'
- 12/22 Arbuckle 3263'
TD 3265'
5" @ 3263'
- 12/29 "
- 1/5 "
- 1/12 "
- 1/19 "

OVER

1949

1/26

Arb. 3263'

5" @ 3263'

Pump 10 oil Pot.

Gr. 40°

TD 3265'

COMPLETED

Map No. _____ Sec. 15 Twp. 32 R. 4E

Well No. 1 State _____

H. H. Blair Company

FIRST REPORT

Contractor _____

NW SE NW

SECTION PLAT

_____ Ft. from N. Line

990 Ft. from S. Line

990 Ft. from E. Line

_____ Ft. from W. Line

Cowley County

Location _____

Rig up _____

Drilling and Remarks:

Machine _____

RECORD

Cased _____ in., _____ ft.

Sand _____

Gas _____

Oil _____

Total Depth _____

PRODUCTION

1st 24 hrs. Nat. _____

1st 24 hrs. after shot _____

Gas _____ Cu. Ft.

Dry Hole _____

Abandoned _____

Date

OCT 27 1948 19

S. J. LEWIS Scout

Map No. 2 Sec. 15 Twp. 32 R. 4 E

Well No. 1 State

H. H. Blair Company

COMPLETE Contractor

NW SE NW

E 11143

SECTION PLAT

_____ Ft. from N. Line

990 Ft. from S. Line

990 Ft. from E. Line

_____ Ft. from W. Line

	4		

Cowley County

Location _____

Rig up _____

Drilling and Remarks:

Ar 13268

5" 13268

Pump 10 oil

40° SW

RECORD

Cased _____ in., _____ ft.

Sand _____

Gas _____

Oil

Total Depth 3265

PRODUCTION

1st 24 hrs. Nat. _____

1st 24 hrs. after shot _____

Gas _____ Cu. Ft.

Dry Hole _____

Abandoned _____

Date

JAN 26 1949

19

S. J. LEWIS

Scout