



*Cowley*

Map No. *Kans* Sec. *15* Twp. *32* R. *4*


Well No. *2-State land* Farm  
*Marland Oil* Company

\_\_\_\_\_ Ft. from N. Line

*200* Ft. from S. Line

\_\_\_\_\_ Ft. from E. Line

*560* Ft. from W. Line

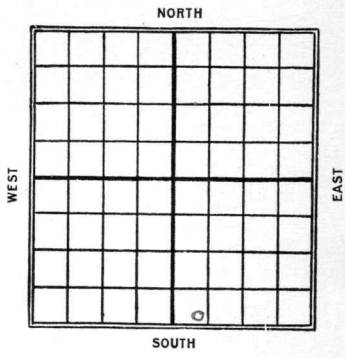

*1926*

Date	REPORT
<i>11/11</i>	<i>Location</i>
<i>11/17</i>	<i>Bldg rig</i>
<i>11/23</i>	<i>Rig up</i>
<i>12/8</i>	<i>Drlg 1300'</i>
<i>12/15</i>	<i>" 1625'</i>
<i>12/22</i>	<i>" 1786</i>
<i>12/30</i>	<i>" 2075</i>
<i>1927</i>	
<i>1/6</i>	<i>Sand 2388-99 - 200' oil in hole</i>
<i>1/13</i>	<i>13 bbb. oil, 27 bbb. water will drill deeper.</i>
<i>1/19</i>	<i>5 m gas 2520-24 -drilling</i>
<i>1/26</i>	<i>small show oil 2547 drlg-</i>
<i>2/3</i>	<i>S.D. 2560</i>
<i>2/10</i>	<i>Drlg 2632</i>
<i>2/17</i>	<i>S.D. 2632</i>
<i>2/24</i>	<i>—</i>
<i>3/2</i>	<i>—</i>
<i>3/9</i>	<i>—</i>
<i>3/16</i>	<i>—</i>
<i>3/24</i>	<i>—</i>
<i>3/30</i>	<i>—</i>

4/7 - S.D. 2632  
4/13 \_\_\_\_\_  
4/20 \_\_\_\_\_  
4/27 \_\_\_\_\_  
5/5 \_\_\_\_\_  
5/12 \_\_\_\_\_  
5/18 \_\_\_\_\_  
5/25 \_\_\_\_\_  
6/1 \_\_\_\_\_  
6/7 \_\_\_\_\_  
6/15 \_\_\_\_\_  
6/22 \_\_\_\_\_  
6/29 \_\_\_\_\_  
7/7 \_\_\_\_\_  
7/13 - \_\_\_\_\_  
7/20 \_\_\_\_\_  
7/28 \_\_\_\_\_  
8/4 \_\_\_\_\_  
8/10 \_\_\_\_\_  
8/18 \_\_\_\_\_  
8/24 \_\_\_\_\_  
9/1 \_\_\_\_\_  
9/7 \_\_\_\_\_  
9/14 \_\_\_\_\_  
9/29 \_\_\_\_\_  
10/6 \_\_\_\_\_

10/12 - Show oil 2388-99  
2520-2524  
T.D. 2632  
1777 gas well

Cowley

2 KANSAS Map No. Sec. 15 Twp. 32 R. 4

Well No. 2 State Land

Marland Oil Co Company

Contractor

SECTION PLAT

\_\_\_\_\_ Ft. from N. Line

200 Ft. from S. Line

\_\_\_\_\_ Ft. from E. Line

560 Ft. from W. Line


FIRST REPORTS

Location ✓ \_\_\_\_\_

Rig up \_\_\_\_\_

Drilling and Remarks:

RECORD

Cased \_\_\_\_\_ in., \_\_\_\_\_ ft.

Sand \_\_\_\_\_

Gas \_\_\_\_\_

Oil \_\_\_\_\_

Total Depth \_\_\_\_\_

PRODUCTION

1st 24 hrs. Nat. \_\_\_\_\_

1st 24 hrs. after shot \_\_\_\_\_

Gas \_\_\_\_\_ Cu. Ft.

Dry Hole \_\_\_\_\_

Abandoned \_\_\_\_\_

Date

NOV 11 1926

CHAS. L. SHERWOOD

192

Scout

Map No. 2 **KANSAS** Sec. 15 Twp. 32 R. 4 *Cowley* ✓

Well No. 2 *State Long*  
*Marlong Oil Co* Company

Contractor

**COMPLETED**

**SECTION PLAT**

\_\_\_\_\_ Ft. from N. Line

200 Ft. from S. Line

\_\_\_\_\_ Ft. from E. Line

560 Ft. from W. Line

		o	

Location \_\_\_\_\_

Rig up \_\_\_\_\_

Drilling and Remarks:

*Show on 2388-99'*

**RECORD**

Cased \_\_\_\_\_ in., \_\_\_\_\_ ft.

Sand \_\_\_\_\_

Gas 2520-2524

Oil \_\_\_\_\_

Total Depth 2632

**PRODUCTION**

1st 24 hrs. Nat. \_\_\_\_\_

1st 24 hrs. after shot \_\_\_\_\_

Gas 1 ~~11~~ Cu. Ft.

Dry Hole \_\_\_\_\_

Abandoned \_\_\_\_\_

Date

OCT 12 1927

CHAS. L. SHERWOOD

192

Scout

*Comp for Gas Well*