




Cowley

Map No. Kansas Sec. 15 Twp. 32 R. 4E

Well No. 5 State land Farm  
J. A. Hull Company

..... Ft. from N. Line  
990 Ft. from S. Line  
330 Ft. from E. Line  
..... Ft. from W. Line

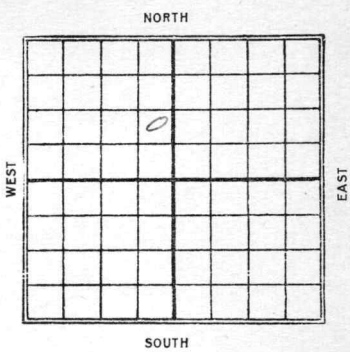

Date	REPORT
1927	
1/19	R.O.G.
1/26	same
2/3	Rign up
2/10	Drlg 300
2/17	" 810
4/24	" 1555
3/2	" 1905
3/9	sand 2275-2355 show O.+G. Drlg 2400
3/16	Drlg 2500
3/24	Setting 8" - 2620
3/30	Drlg 2820
4/7	Sil. line 3268-74 - 420 bbls 1st 18 hrs. - 463 bbls. next 19 hrs.
4/13	sand 3268-3277 show O.+G. 2275-2355 1002 bbls 1st 24 hrs

Cowley

2 KANSAS

Map No. \_\_\_\_\_ Sec. 15 Typ. 32 R. 4

Well No. 5 State Land

J. H. Sule Company

Contractor

FIRST REPORTS

SECTION PLAT

\_\_\_\_\_ Ft. from N. Line

990 Ft. from S. Line

330 Ft. from E. Line

\_\_\_\_\_ Ft. from W. Line

	o		

Location R 4

Rig up

Drilling and Remarks:

RECORD

Cased \_\_\_\_\_ in., \_\_\_\_\_ ft.

Sand \_\_\_\_\_

Gas \_\_\_\_\_

Oil \_\_\_\_\_

Total Depth \_\_\_\_\_

PRODUCTION

1st 24 hrs. Nat. \_\_\_\_\_

1st 24 hrs. after shot \_\_\_\_\_

Gas \_\_\_\_\_ Cu. Ft.

Dry Hole \_\_\_\_\_

Abandoned \_\_\_\_\_

Date

JAN 10 1909

CHAS. L. SHERWOOD

Cowley

Map No. 2 KANSAS Sec. 15 Twp. 32 R. 4

Well No. 5 State Land

G. H. Dull Company

Contractor

COMPLETED

SECTION PLAT

----- Ft. from N. Line

990 Ft. from S. Line

330 Ft. from E. Line

----- Ft. from W. Line

	o		

Location -----

Rig up -----

Drilling and Remarks:

Show logs 2278-2355

RECORD

Cased \_\_\_\_\_ in., \_\_\_\_\_ ft.

Sand 3268-3277

Gas -----

Oil -----

Total Depth 3277'

PRODUCTION

1st 24 hrs. Nat. -----

1st 24 hrs. after shot -----

Gas ----- Cu. Ft.

Dry Hole -----

Abandoned -----

1002 Bl  
1st 24 hrs.

Date

APR 13 1927

**CHAS. L. SHERWOOD**

192

Scout