


Section 26 Township 18 Range 10-W

Well No. #2 Roelfs

Company Sunray
Orth Pool

NORTH

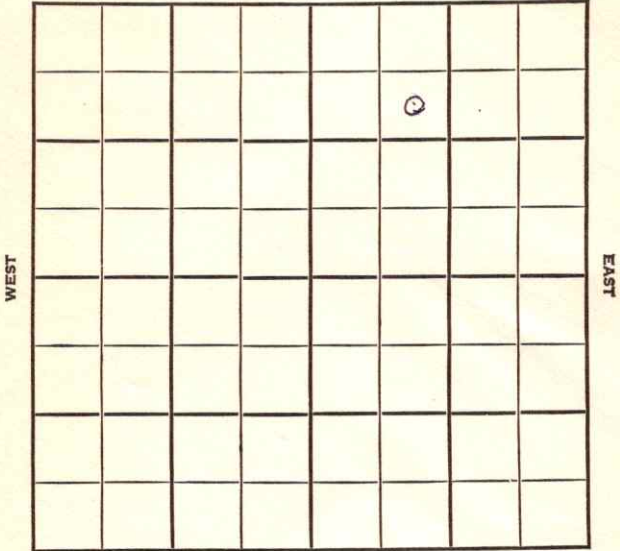

SOUTH

WEST

EAST

KANSAS

Rice

Sec. 26 Twp. 18 R. 10W

Well No. #2 Roelfs Farm
Sunray Company
Orth


990 Ft. from N. Line

_____ Ft. from S. Line

_____ Ft. from E. Line

990 Ft. from W. Line

SE NW NE

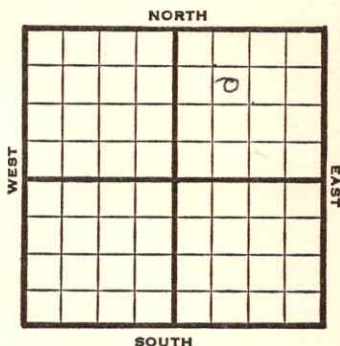

1948

Eli 1749'

REPORT

6/1

Anhy. 410'
8" @ 288'
Drlg. 1720'

6/9

Topoka 2458'
Lansing 2863'
Quartzite 3202-05'
TD 3203'

6/16

"

6/23

"

6/29

"

7/8

"

"

7/14

"

"

7/21

"

"

7/28

"

"

8/4

"

8/11

"

"

8/18

Quartzite 3202'
5" @ 3203'
TD 3205'
Pump 120' oil Pot
40° Gr.
Comp

COMPLETED

Map No. _____ Sec. 26 Twp. 18 R. 10W

Well No. 2 Roelf's

Sunray _____ Company

FIRST REPORT

Contractor

SE NW NE

SECTION PLAT

990 Ft. from N. Line

_____ Ft. from S. Line

_____ Ft. from E. Line

990 Ft. from W. Line

Rice County

Location _____

Rig up _____

Drilling and Remarks:

Anhy 410

8" @ 288

drlg. 1720

RECORD

Cased _____ in., _____ ft.

Sand _____

Gas _____

Oil _____

Total Depth _____

PRODUCTION

1st 24 hrs. Nat. _____

1st 24 hrs. after shot _____

Gas _____ Cu. Ft.

Dry Hole _____

Abandoned _____

Date

JUN 1 1948 19

S. J. LEWIS Scout

Rice County Kansas State

Map No. 55 Sec. 26 Twp. 18 R. 10W

Well No. 2 Roelf's

Sunray Company

COMPLETE Contractor

SE NW NE

E 11749
SECTION PLAT

990 Ft. from N. Line

 Ft. from S. Line

 Ft. from E. Line

990 Ft. from W. Line

Orth Pool

Remarks:

Quartzite 3202

5" @ 3203

77 3205

Pump 120 oil Pd

40' @

Date
AUG 18 1948

Scout
S. J. LEWIS