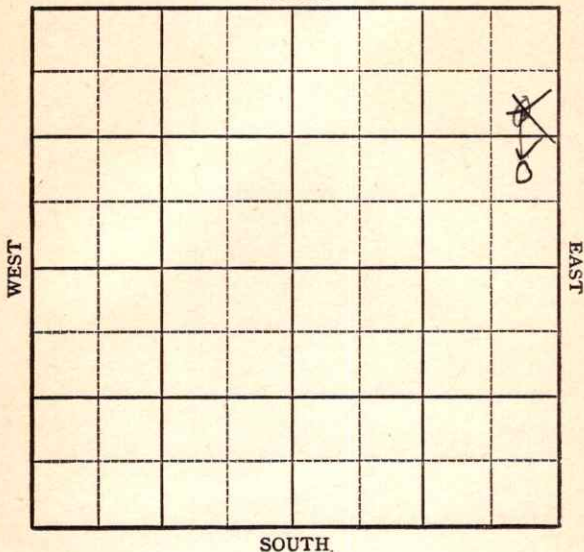


KANSAS

Rice

Section 26 Township 18 Range 10WWell No. 3 CulbertsonCompany Hinkle OilOrth Pool
NORTH

Rice

KANSAS


Sec. 26 Twp. 18 R. 10W

Well No. #3 Culbertson Farm

Hinkle Oil

Orth Pool

Company

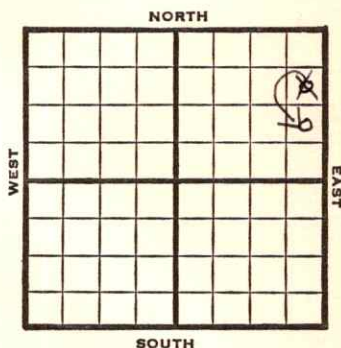

~~990'~~ Ft. from N. Line

990' Ft. from S. Line

330' Ft. from E. Line

Ft. from W. Line

NE SE NE
SE NE NE

1948

Eli 1738'

REPORT

9/8

8" @ 192'

Anhy 400'

Drlg. 2182'

9/14

Lansing 2866'

Sooy 3187'

Quartzite 3252'-54'

TD 3254'

5" @ 3254'

9/21

"

9/29

12 shots 3185-89 SO

9 shots 3182-85

24 shots 3183-92 270' oil

10/6

"

10/13

"

10/20

TD 3254'

Sooy 3187'

Quartzite 3252'

5" @ 3254'

Perf Sooy

Pump 4 Oil Pot

41° Gr.

Comp

COMPLETED

Rice County Kansas State
 Map No. _____ Sec. 26 Twp. 18 R. 10W
 Well No. 3 Culbertson
Hinkle Oil Company

FIRST REPORT Contractor

SE NE NE

SECTION PLAT

990 Ft. from N. Line

_____ Ft. from S. Line

330 Ft. from E. Line

_____ Ft. from W. Line

Orth Pool

Remarks:

8" @ 192 Anhy 400 drlg. 2182

Date
SEP 8 1948

Scout S. J. LEWIS

Rice County Kansas State
Map No. 55 Sec. 26 Twp. 18 R. 10W

Map No. 55 Sec. 26 Twp. 18 R. 10W

Well No. 3 Culbertson

Hinkle Oil Company

CORRECTION	Contractor
------------	------------

NE SE NE

SECTION PLAT


Ft. from N. Line

990 Ft. from S. Line

330 Ft. from E. Line

Ft. from W. Line

Orth Pool

Remarks:

Reported SE NE NE

Date _____

SEP 8 1948

Scout

Scout S. J. LEWIS

Map No. 55 Sec. 26 Twp. 18 R. 10W

Well No. 3 Culbertson

Hinkle Oil Company

COMPLETE

Contractor

NE SE NE

E 1/2 S
SECTION PLAT

990 Ft. from N. Line

330 Ft. from S. Line

330 Ft. from E. Line

 Ft. from W. Line

Rice County

RECORD

Location

Cased in., ft.

Rig up

Sand

Drilling and Remarks:

Gas

Oil

Total Depth 825 4

PRODUCTION

1st 24 hrs. Nat.

1st 24 hrs. after shot

Gas Cu. Ft.

Dry Hole

Abandoned

Date

OCT 20 1948

19

S. J. LEWIS

Scout