


KANSAS

Rice

Section 26 Township 18 Range 10-W

Well No. #3 Roelfs

Company Bay Petroleum

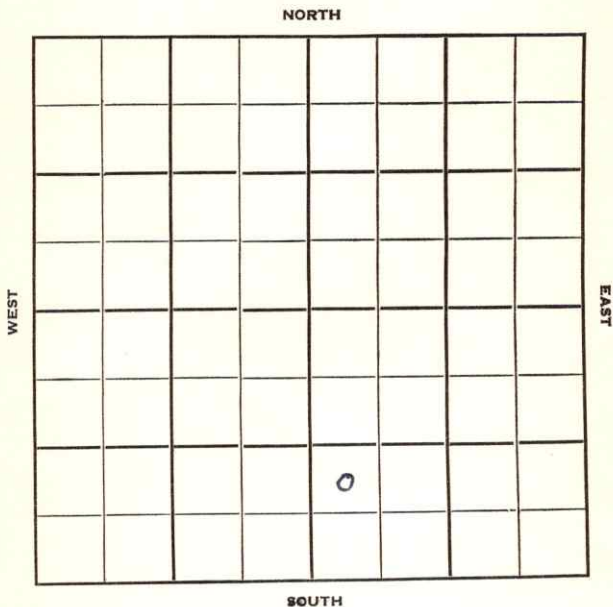

KANSAS

Rice

Sec. 26 Twp. 18 R. 10-W

Well No. #3 Roelfs Farm

Bay Petroleum Company

Stickle Drlg. Contractor

Orth


_____ Ft. from N. Line

990 Ft. from S. Line

_____ Ft. from E. Line

330 Ft. from W. Line

NW SW SE

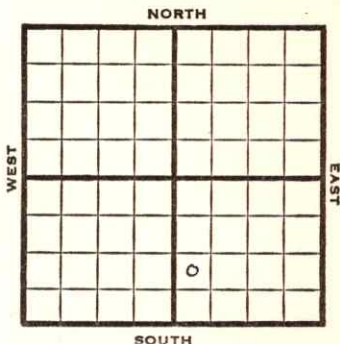

1950

Elev 1748' REPORT

11/1 Spud 10-25-50
8 5/8" @ 285
Anhy 415
Drlg 2664

12/20 8 5/8" @ 285
Anhy 415 **Top 2476**
Br lime 2865 **Lans 2879**
DST 3060-76 opn 1/2 hr rec 126' gcm SSO
5" @ 3241
TD 3268
3/4 bw 1/3 boph
DD 3291
PB 3250
Hydrafrac 3242-50
S/30 boph
Comp 204 bopd 10 bw
Completed TD 3291'

COMPLETED

