


Map No. **KANSAS** Sec. 31 Twp. 13 R. 15W
 Well No. 1- Polcyn Farm
Alyward et al Company

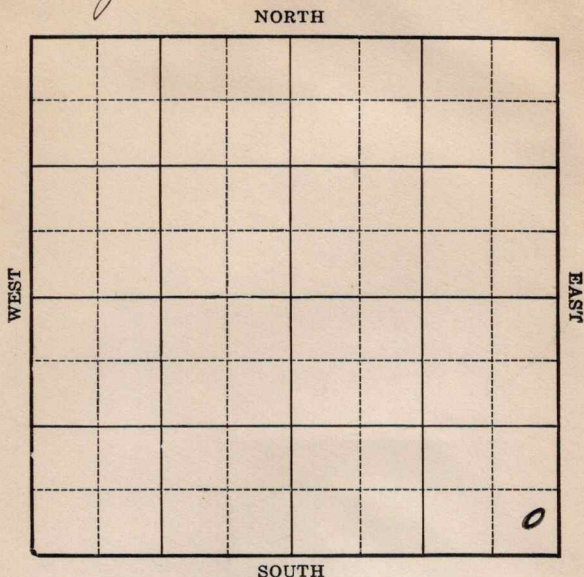

Location _____

Drilling Remarks _____

Rig Up _____

Drilling Remarks _____

RECORD

Cased _____ in. _____ ft.

Sand _____

Gas _____

Oil _____

Total Depth _____

PRODUCTION

1st 24 hrs. Nat. _____

1st 24 hrs. after shot _____

Gas _____ cu. ft.

Dry Hole _____

Abandoned _____

Russell

Map No. KANSAS Sec. 31 Twp. 13 R. 15W


Well No. 1- Polcym Farm
Alyward et al Company

 Ft. from N. Line

330 Ft. from S. Line

330 Ft. from E. Line

 Ft. from W. Line

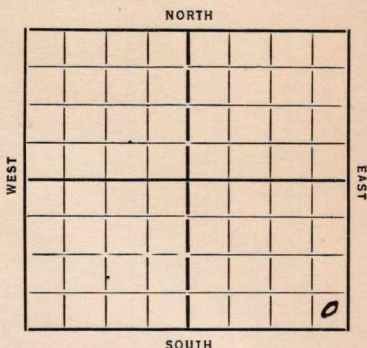

Date 7/3/5

REPORT

4/10 Rig
4/18 dly 395
4/26 15" 405 12" 620 an 955
10" 970 dly 1430
5/2 dly 2550 8" 2513
5/9 Top 2785 s.o. 2825-30
sw 2890 u R 8"
5/16 ~~2830 5" 3054~~
5/16 dly 2910 8" 2905
5/23 8" 2911 aswalk 3060
6" 3053 HFW 3150-60
u R 6" 3180
5/28 Granite Wash 3311
T 17 3400
17.0 A.

ABANDONED

KANSAS

Map No. 72 Sec. 31 Twp. 13 R. 15ⁿWell No. 1- Paleyn
Allyward et al Company

Contractor

FIRST REPORTS

SECTION PLAT

Ft. from N. Line

330 Ft. from S. Line330 Ft. from E. Line

Ft. from W. Line

Location

Rig up

Drilling and Remarks:

Rig

RECORD

Cased _____ in., _____ ft.

Sand _____

Gas _____

Oil _____

Total Depth _____

PRODUCTION

1st 24 hrs. Nat. _____

1st 24 hrs. after shot _____

Gas _____ Cu. Ft.

Dry Hole _____

Abandoned _____

Date

4-10-35

192

ORVAL MANNSCHRECK

Scout

Map No. K 72 Sec. 31 Twp. 13 R. 15W

Well No. 1- Polcy n

Allyward et al Company

Contractor

ABANDONED

SECTION PLAT

Ft. from N. Line

330 Ft. from S. Line

330 Ft. from E. Line

Ft. from W. Line

			0

Location

Rig up

Drilling and Remarks:

Grande wash

3311

NO H

RECORD

Cased in., ft.

Sand

Gas

Oil

Total Depth 3400

PRODUCTION

1st 24 hrs. Nat.

1st 24 hrs. after shot

Gas Cu. Ft.

Dry Hole

Abandoned

Date

5-28-35

192

ORVAL MANNSCHRECK

Scout