



Powley

FORM 252A-5M-12-28-PETROL

Map No. KANSAS Sec. 15 Twp. 32 R. 4

Well No. 3 - State land Farm


M<sup>c</sup> Nabb & Indep. Company

990 Ft. from N. Line

\_\_\_\_\_ Ft. from S. Line

\_\_\_\_\_ Ft. from E. Line

1120 Ft. from W. Line

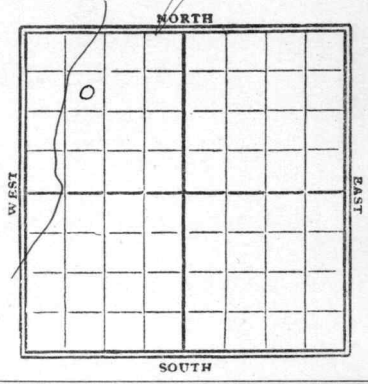

1929

Date	REPORT
4/24	Cellar
5/11	Timbers
5/18	Wagon up.
5/15	Welly 35' 3"
5/22	" 12' 15"
5/29	fsg 15' 85"
6/15	Welly 15' 98"
6/12	" 19' 50"
6/19	7 1/4 gas & show oil from 2295-2325'
6/26	fsg 24' 40"
7/2	— 9' 18" —
7/10	— 9' 25" —
7/17	—
7/24	— (over)
7/31	—
8/7	—
8/14	—
8/21	—
8/28	—
9/4	—
9/11	—

1929

10/2- T.D. 2440'

Skidded rig 70' east

10/9- Spdy 275' (new hole)

10/16- drlg 875'

10/23- " 1465'

10/30- " 1650'

11/6- " 2030'

11/13- " 2355'

11/20- " 2408'

11/27- " 2655'

12/4- " 3060'

12/11- sand 3255-57 1/2'

T.D. 3257 1/2'

Making 75 bbl oil  
and 90 " water  
Pump.

*Cowley*

Map No. **KANSAS** Sec. *15* Twp. *35* R. *4*

Well No. *23* *State Land*

*Mc Nabbs & Independent* Company

Contractor


SECTION PLAT

*990* Ft. from N. Line

..... Ft. from S. Line

..... Ft. from E. Line

*1170* Ft. from W. Line

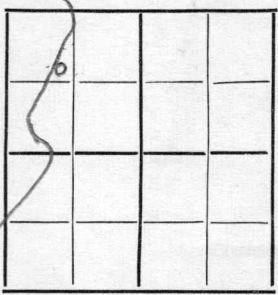

FIRST REPORTS

Location.....

Rig up *Cellar*.....

Drilling and Remarks:

RECORD

Cased..... in., ..... ft.

Sand.....

Gas.....

Oil.....

Total Depth.....

PRODUCTION

1st 24 hrs. Nat.....

1st 24 hrs. after shot.....

Gas..... Cu. Ft.

Dry Hole.....

Abandoned.....

Date

**APR 24 1929**

192..... Scout

**CHAS. L. SHERWOOD**

Cowley

2 KANSAS Map No. Sec. 15 Twp. 32 R. 4E

Well No. 3 State land

Mc Kabb & Independent Company

Contractor

COMPLETE

SECTION PLAT

990 Ft. from N. Line

Ft. from S. Line

Ft. from E. Line

1170 Ft. from W. Line

0			

Location

Rig up

Drilling and Remarks:

75 lbs oil.

90 " water.

RECORD

Cased 3 in., ft.

Sand 2255-3257 1/2

Gas

Oil

Total Depth 2257 1/2

PRODUCTION

1st 24 hrs. Nat.

1st 24 hrs. after shot

Gas Cu. Ft.

Dry Hole

Abandoned

Date DEC 1 1 1929

CHAS. L. SHERWOOD

192 Scout