

Section 26 Township 18 Range 10-W

Well No. 1 Roelfs Culbertson

Company Transwestern

Orth Pool

NORTH

WEST

EAST


SOUTH

Sec. 26 Twp. 18 R. 10-WWell No. #1 Culbertson Roelfs FarmTranswestern Company

(Orth)

990 Ft. from N. Line Ft. from S. Line660 Ft. from E. Line Ft. from W. Line

Elev. 1745

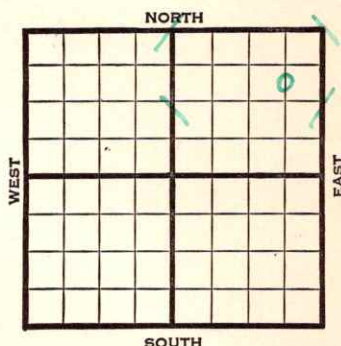

1941

REPORT

1/8

Location

1/16

8" - 280' Drlg. 900'

1/23

Drlg. 2900'

1/30

Lans. 2868' Quartzite 3175-76'

TD 3176' 5" - 3176' RUST.

2/6

Quartzite 3175-83' 2000' oil.

22 hours. Shale 3183-3211'

Quartzite 3211-19' T.D.

Run liner.

2/13

T.D. 3221' H.F.O. 52' of 4" liner on bottom.

2/20

" " "

2/26

Quartzite 3211'

5" - 3176'

T.D. 3221'

52' - 4" liner perforated, on bottom.

Echometer potential 6938 bbls.

Maximum 3000 bbls.

41.5 Gravity

COMPLETED

Map No. 55 Sec. 26 Twp. 18 R. 10WWell No. 1 CulbertsonTranswestern

Company

FIRST REPORT


Contractor

C S L NE NE

SECTION PLAT

990 Ft. from N. Line Ft. from S. Line660 Ft. from E. Line Ft. from W. Line

ORTH POOL

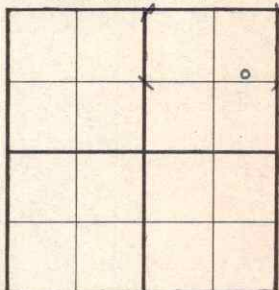Location X

RECORD

Cased in., ft.Sand Gas Oil Total Depth Rig up

Drilling and Remarks:

PRODUCTION

1st 24 hrs. Nat. 1st 24 hrs. after shot Gas Cu. Ft.Dry Hole Abandoned

Date

JAN 8 1941 19

S. J. LEWIS

Scout

Map No. 55 Sec. 26 Twp. 18 R. 10WWell No. 1 Roelfs

Transwestern

Company

CORRECTION

Contractor

SECTION PLAT

C S L NE NE

990 Ft. from N. Line

Ft. from S. Line

660 Ft. from E. Line

Ft. from W. Line

ORTH POOL

Location _____

Rig up _____

Drilling and Remarks:

Reported as

#1 Culbertson

RECORD

Cased _____ in., _____ ft.

Sand _____

Gas _____

Oil _____

Total Depth _____

PRODUCTION

1st 24 hrs. Nat. _____

1st 24 hrs. after shot _____

Gas _____ Cu. Ft.

Dry Hole _____

Abandoned _____

Date

JAN 23 1941

19

S. J. LEWIS Scout

Map No. 55 Sec. 26 Twp. 18 R. 10WWell No. 1 RoelfsTranswestern CompanyCOMPLETED Contractor

C S L NE NE

990 Ft. from N. Line Ft. from S. Line660 Ft. from E. Line Ft. from W. Line

ORTH POOL

SECTION PLAT

			o

Location Rig up

Drilling and Remarks:

*Quartzite 3211**5" CB 176.**52'-4" well Perforated
on bottom**E. prod. 6938**Plat 3000**41.5 Gr.*

RECORD

Cased in., ft.Sand Gas Oil Total Depth 3221

PRODUCTION

1st 24 hrs. Nat. 1st 24 hrs. after shot Gas Cu. Ft.Dry Hole Abandoned

Date

FEB 26 1941 19

S. J. LEWIS Scout