


Section 26 Township 18 Range 10W

Well No. 2 Culbertson

Company Hinkle, Apex & Brooks

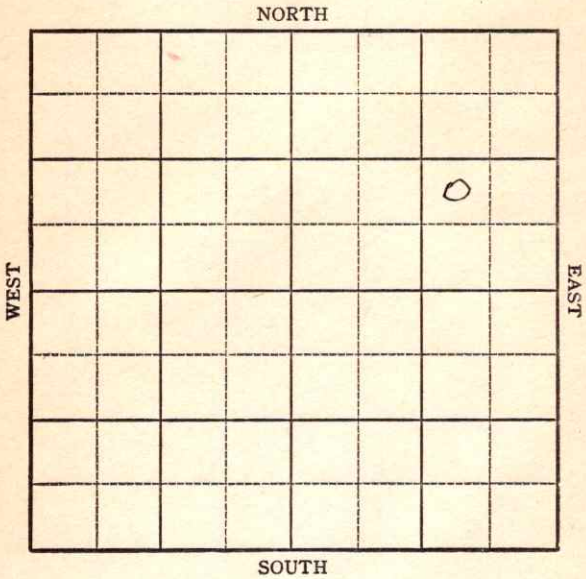

KANSAS

Rice

Sec. 26 Twp. 18 R. 10W

Well No. #2 Culbertson Farm

Hinkle, Apex & Brooks Company


Orth Pool

_____ Ft. from N. Line

990' Ft. from S. Line

990' Ft. from E. Line

_____ Ft. from W. Line

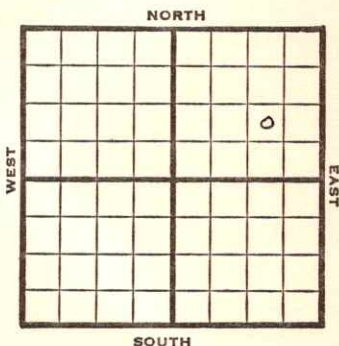

NW SE NE

1948

^E
li 1744'

REPORT

7/28

8" @ 192'
WOC

8/4

Drlg. 2686'

8/11

Lansing 2862'
Quartzite 3239'
TD 3248'
5" @ 3241' W
Plug 3206'-

8/18

48 shots 3189097
Swb 37 bbls oil PH
Quartzite 3239'
5" @ 3241'
TD 3248'
500 acid
Pump 75 Oil / W Pot
40° Gr.
Comp

COMPLETED

Rice County Kansas State

Map No. 55 Sec. 26 Twp. 18 R. 10W

Well No. 2 Culbertson

Hinkle, Apex & Brooks Company

COMPLETE

Contractor

NW SE NE

E 11744

SECTION PLAT

 Ft. from N. Line

990 Ft. from S. Line

990 Ft. from E. Line

 Ft. from W. Line

Orth Pool

Remarks:

Quartzite 8239

5" @ 3241

W 3248

500 acs

Pump 75 oil + W 3248

40° S

Date

AUG 18 1948

Scout

S. J. LEWIS