


Map No. _____ Sec. 8 Twp. 27 R. 9Well No. 1 Buellis Farm _____Beaumont Company _____

NORTH

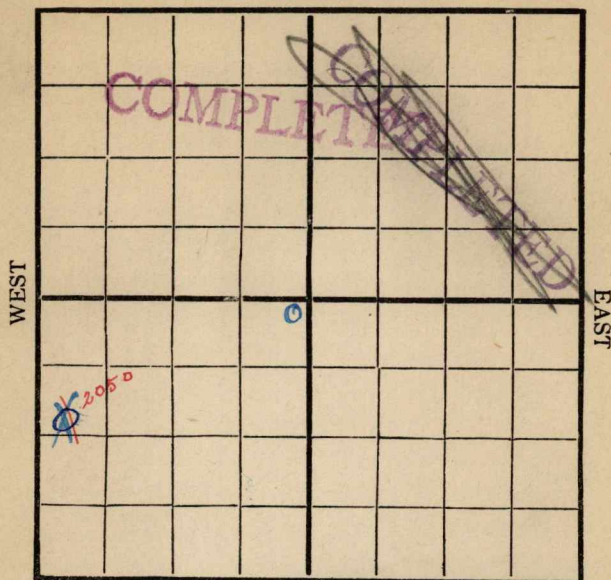

SOUTH

Location _____

Rig Up _____

Drilling Remarks:

Drilling Remarks:

9/30 - 1050 - S.D. for underreamer10/7 - 1065 - S.D. = 10/14: 10/21:10/28 - 141011/4 = 148011/8 = 1505 = 11/2512/2 = 1975 = 12/912/22 = 2050 = 12/28

RECORD

Cased _____ in _____ Ft.

Sand _____

Gas _____

Oil _____

Total Depth _____

PRODUCTION

1st 24 hrs. Nat. _____

1st 24 hrs. after shot _____

Gas _____ Cu. Ft.

Dry Hole _____

Abandoned _____

Map No. _____ Sec. 8 Twp. 27 R. 9Well No. 1 B eedles Farm _____Derby & Walker Company _____

NORTH

WEST

EAST

SOUTH

Location ✓ _____

Rig Up _____

Drilling and remarks

rig on car
at Beaumont.

RECORD

Cased _____ in. _____ Ft.

Sand _____

Gas _____

Oil _____

Total Depth _____

PRODUCTION

1st 24 hrs. Nat. _____

1st 24 hrs. after shot _____

Gas _____ Cu. Ft.

Dry Hole _____


Abandoned _____

Date

June 19, 191 6 H. Farnsworth Scout 80

Map No. _____ Sec. 8 Twp. 27^S R. 9^EWell No. _____ Beedles FarmBeaumont Oil & Gas Co. Wichita Kan
CompanyGreenwood County Kan.
NORTH

WEST

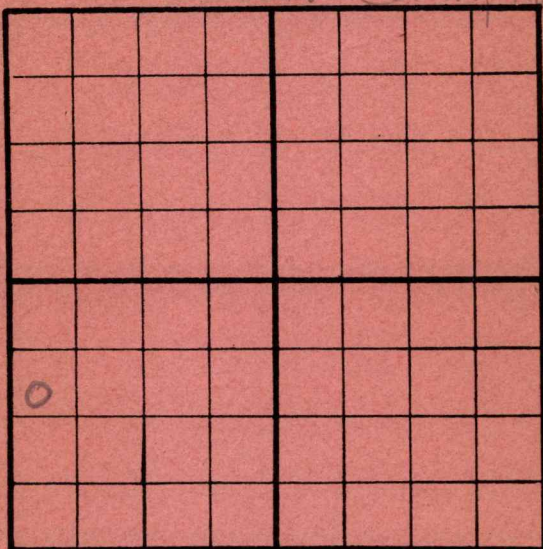

EAST

SOUTH

Location _____

Rig up going in

Drilling and remarks _____

RECORD

Cased _____ in. _____ Ft.

Sand _____

Gas _____

Oil _____

Total Depth _____

PRODUCTION

1st 24 hrs. Nat. _____

1st 24 hrs. after shot _____

Gas _____ Cu. Ft.

Dry Hole _____

Abandoned _____

Date 6/22⁴, 1916,


Scout

Map No. _____ Sec. 8 Twp. 27 R. 9
 Well No. 1 Beedley Farm
Derby & Walker Company

NORTH

WEST

EAST

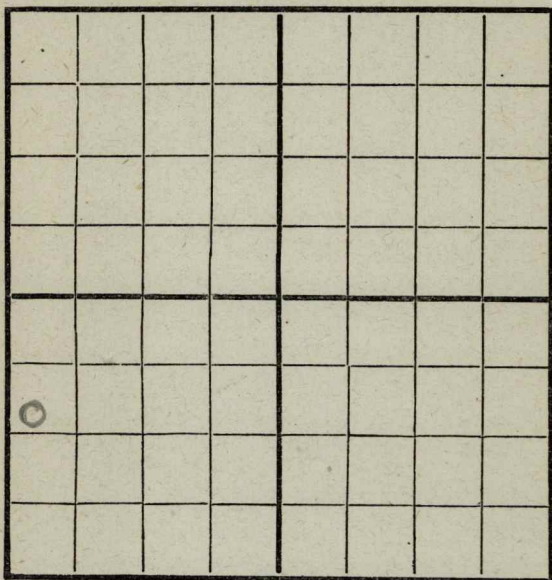

SOUTH

Location _____

Rig Up _____

Drilling and remarks

Big building.

Tools moving in.

RECORD

Cased _____ in. _____ Ft.

Sand _____

Gas _____

Oil _____

Total Depth _____

PRODUCTION

1st 24 hrs. Nat. _____

1st 24 hrs. after shot _____

Gas _____ Cu. Ft.

Dry Hole _____

Abandoned _____


Date

June 24, 1916 *H. Farnsworth* Scout

Map No. _____ Sec. 8 Twp. 27 R. 9Well No. 13 eedles Farm _____Derby & Walbey Company _____

NORTH

WEST

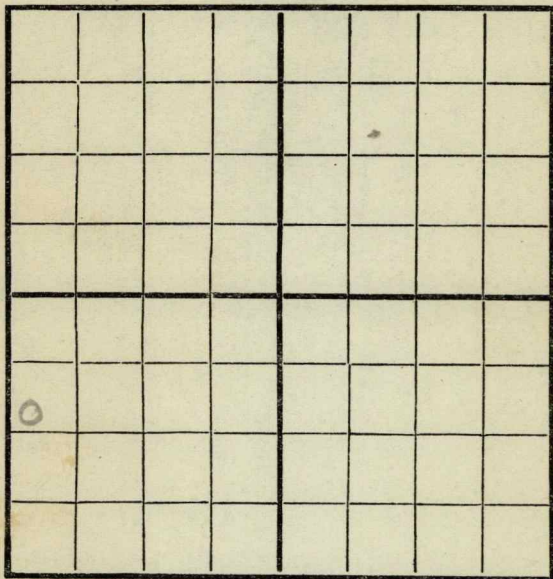

EAST

SOUTH

Location _____

Rig Up ☒ _____

Drilling and remarks

Rigging up.

RECORD

Cased _____ in. _____ Ft.

Sand _____

Gas _____

Oil _____

Total Depth _____

PRODUCTION

1st 24 hrs. Nat. _____

1st 24 hrs. after shot _____

Gas _____ Cu. Ft.

Dry Hole _____

Abandoned _____

Date


July 4, 1916 H. Farnsworth Scout

Map No. _____ Sec. 8 Twp. 27 R. 9Well No. 1 Buddis FarmDerby & Walker Company

NORTH

WEST

EAST

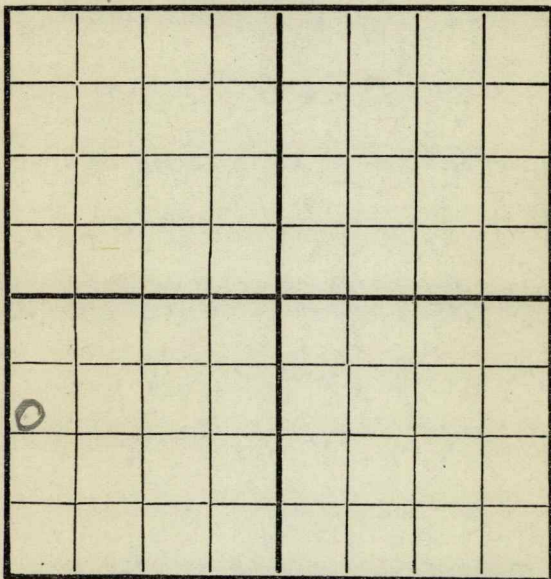

SOUTH

Location _____

Rig Up _____

Drilling and remarks

*Started to
spud.*

RECORD

Cased _____ in. _____ Ft.

Sand _____

Gas _____

Oil _____

Total Depth _____

PRODUCTION

1st 24 hrs. Nat. _____

1st 24 hrs. after shot _____

Gas _____ Cu. Ft.

Dry Hole _____

Abandoned _____

Date


July 6, 1916 *H. Farnsworth* Scout

Map No. _____ Sec. 8 Twp. 27 R. 9
 Well No. 1 Beedles Farm _____
Beaumont Oil Company _____

NORTH

WEST

EAST

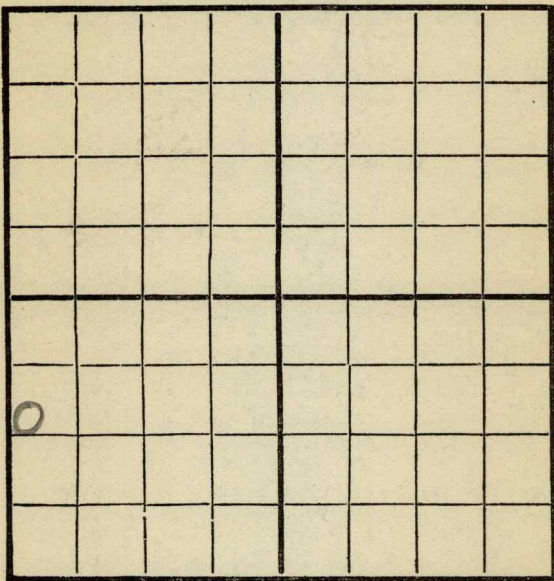

SOUTH

Location _____

Rig Up _____

Drilling and remarks

S.D. 225-

RECORD

Cased _____ in. _____ Ft.

Sand _____

Gas _____

Oil _____

Total Depth _____

PRODUCTION

1st 24 hrs. Nat. _____

First 24 h.s. after shot _____

Gas _____ Cu. Ft.

Dry Hole _____

Abandoned _____

Date

8/7, 1916 H. Farnsworth Scout

Map No. _____ Sec. 8 Twp. 27 R. 9
Well No. 1 Beedley Farm
Beaumont Oil Company

NORTH

WEST

EAST

SOUTH

Location _____

Rig Up-----

Drilling and remarks

S. H. 220-

RECORD

Cased-----in. -----Ft.

Sand_____

Gas _____

Oil_____

Total Depth_____

PRODUCTION

1st 24 hrs. Nat.-----

1st 24 hrs. after shot_____

Gas _____ Cu. Ft.

Dry Hole_____

Abandoned.....

Date _____

Date 8/19, 1916. H. Farns Scout

Greenwood

Map No. _____ Sec. 8 Twp. 27 R. 9

Well No. 1 Beedles Farm

Beaumont Oil Company

NORTH

WEST EAST

SOUTH

Location _____

Rig Up-----

Drilling and remarks

390

RECORD

Cased _____ in. _____ Ft.

Sand-----

Gas _____

Oil _____

Total Depth_____

PRODUCTION

1st 24 hrs. Nat.-----

1st 24 hrs. after shot-----

Gas _____ Cu. Ft.

Dry Hole_____

Abandoned_ _ _ _ _

Date _____

ate
8/26 1916

Excess


Scout

Greenwood 8 Twp. 27 R. 9
 Map No. Sec. Twp. R.
 Well No. 1 Beedles Farm
Beaumont Oil Company

NORTH

WEST

EAST

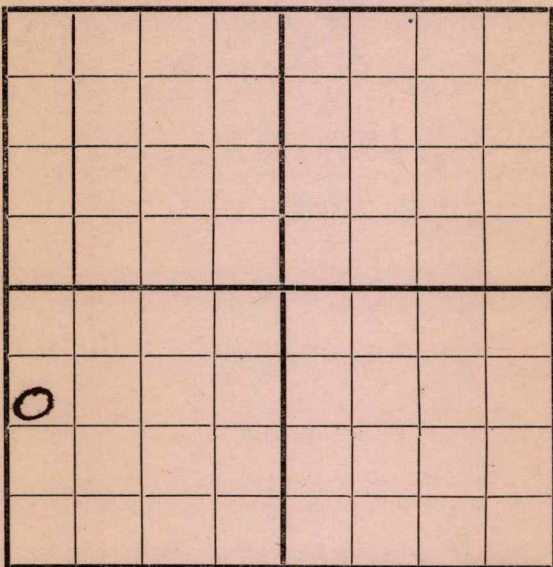

SOUTH

Location

Rig Up

Drilling and remarks

830

RECORD

Cased 10 in. 790 Ft.

Sand

Gas

Oil

Total Depth

PRODUCTION

1st 24 hrs. Nat.

1st 24 hrs. after shot

Gas Cu. Ft.

Dry Hole

Abandoned

Date

9/9

1916

E. H. Green

Scout


Map No. _____ Sec. 8 Twp. 27 R. 9

Well No. 1 Beedles Farm
Beaumont Oil Company

NORTH

WEST

EAST

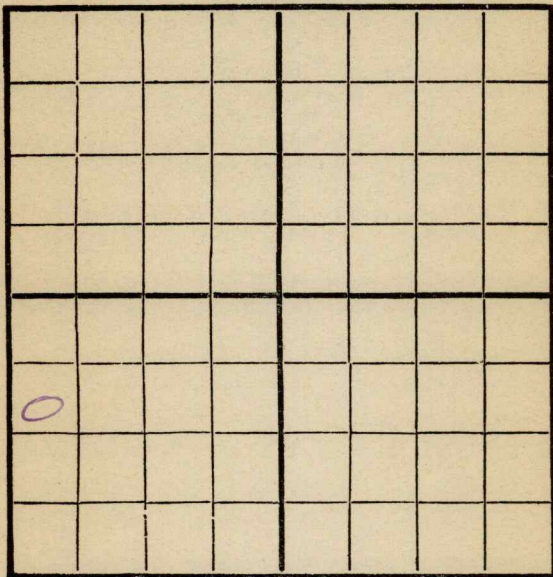

SOUTH

Location _____

Rig Up _____

Drilling and remarks

✓
1045

RECORD

Cased _____ in. _____ Ft.

Sand _____

Gas _____

Oil _____

Total Depth _____

PRODUCTION

1st 24 hrs. Nat. _____

First 24 hrs. after shot _____

Gas _____ Cu. Ft.

Dry Hole _____

Abandoned _____

Date

9/16, 191 6

6


Scout

Map No. _____ Sec. 8 Twp. 27 R. 9

Well No. 1 Beedles Farm
Beaumont Oil Company

NORTH

WEST

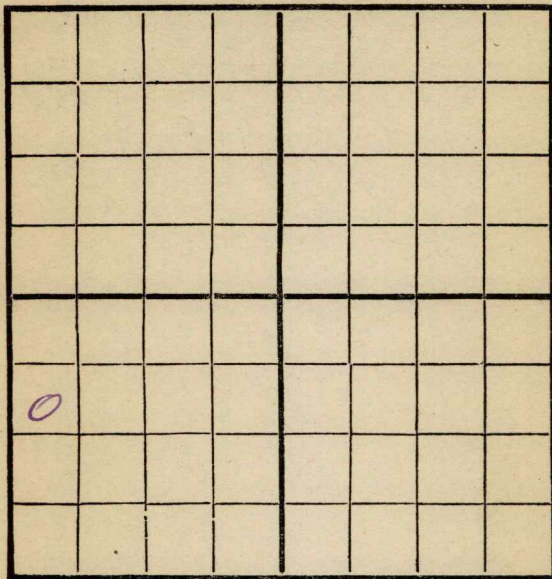

EAST

SOUTH

Location _____

Rig Up _____

Drilling and remarks

U.R. 1050

RECORD

Cased _____ in. _____ Ft.

Sand _____

Gas _____

Oil _____

Total Depth _____

PRODUCTION

1st 24 hrs. Nat. _____

First 24 hrs. after shot _____

Gas _____ Cu. Ft.

Dry Hole _____

Abandoned _____

Date

9/23

191 6

E. Everett


Scout

Greenwood
 Map No. _____ Sec. *8* Twp. *27* R. *9*
 Well No. *1 Beedles* Farm
Beaumont oil Company

NORTH

WEST

EAST

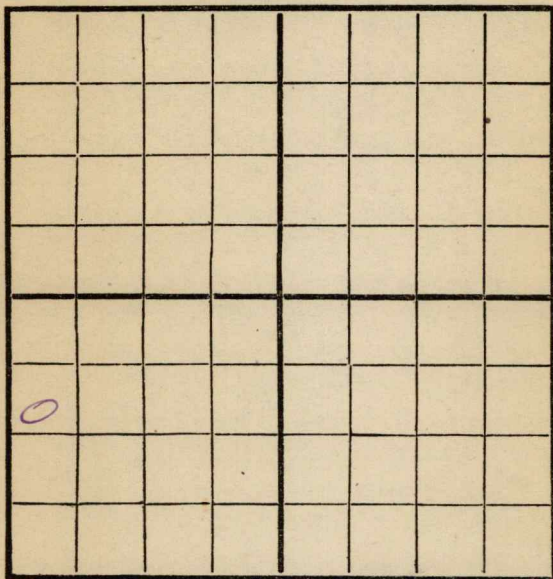

SOUTH

Location _____

Rig Up _____

Drilling and remarks

S.D. 1050
waiting for
underreamer.

RECORD

Cased _____ in. _____ Ft.

Sand _____

Gas _____

Oil _____

Total Depth _____

PRODUCTION

1st 24 hrs. Nat. _____

1st 24 hrs. after shot _____

Gas _____ Cu. Ft.

Dry Hole _____

Abandoned _____


Date

9/30, 191 *6* *E. Everett* Scout

Map No. Greenwood Sec. 8 Twp. 27 R. 9
 Well No. 1 Beedles Farm
Beaumont Oil Company

NORTH

WEST

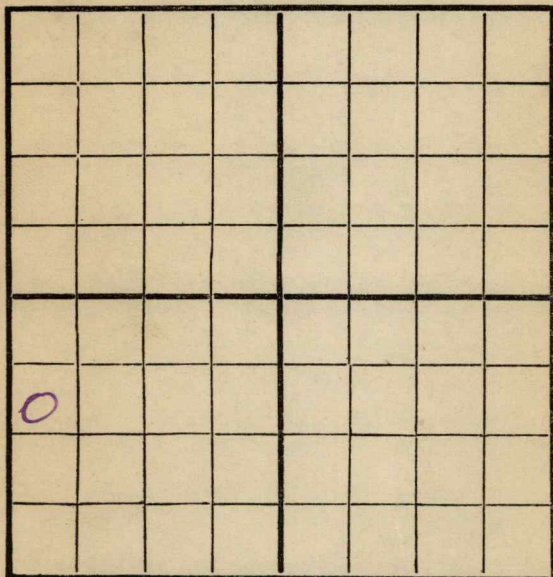

EAST

SOUTH

Location _____
 Rig Up _____
 Drilling and remarks

SD-1065

RECORD

Cased _____ in. _____ Ft.
 Sand _____
 Gas _____
 Oil _____
 Total Depth _____

PRODUCTION

1st 24 hrs. Nat. _____
 1st 24 hrs. after shot _____
 Gas _____ Cu. Ft.
 Dry Hole _____
 Abandoned _____

Date

10/7

1916


E. H. West

Scout

Greenwood
 Map No. _____ Sec. *8* Twp. *27* R. *9*
 Well No. *1 Beedles* Farm _____
Beaumont Oil Company

NORTH

WEST

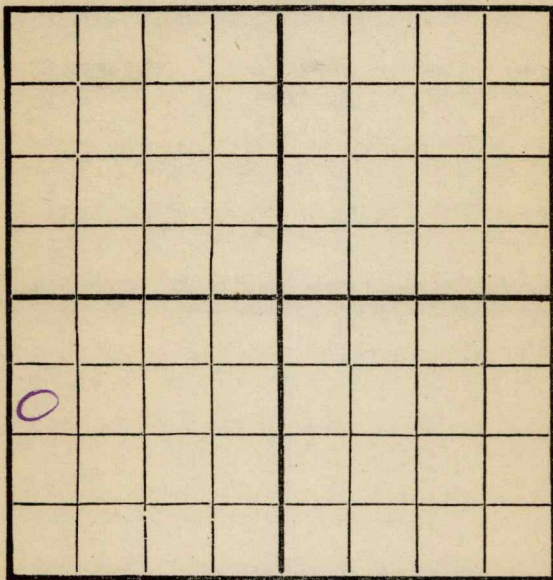

EAST

SOUTH

Location _____

Rig Up _____

Drilling and remarks

SD-1065

RECORD

Cased _____ in. _____ Ft.

Sand _____

Gas _____

Oil _____

Total Depth _____

PRODUCTION

1st 24 hrs. Nat. _____

First 24 hrs. after shot _____

Gas _____ Cu. Ft.

Dry Hole _____

Abandoned _____

Date


10/14, 191 *6**Ernest*

Scout

GREENWOODMap No. _____ Sec. 8 Twp. 27 R. 9Well No. 1 Beedles FarmBeaumont Oil Company

NORTH

WEST

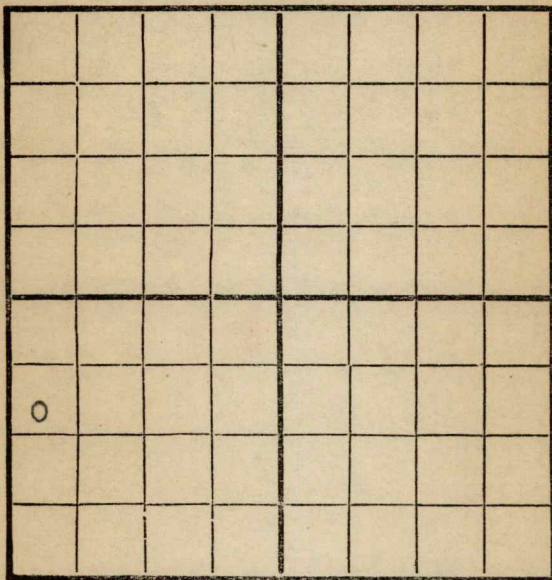

EAST

SOUTH

Location _____

Rig Up _____

Drilling and remarks

SA-1065

RECORD

Cased _____ in. _____ Ft.

Sand _____

Gas _____

Oil _____

Total Depth _____

PRODUCTION

1st 24 hrs. Nat. _____

First 24 hrs. after shot _____

Gas _____ Cu. Ft.

Dry Hole _____

Abandoned _____

Date

OCT 21 1916


191

E. H. WEST

Scout

GREENWOODMap No. _____ Sec. 8 Twp. 27 R. 9Well No. 1 Beedles FarmBeaumont Oil Company

NORTH

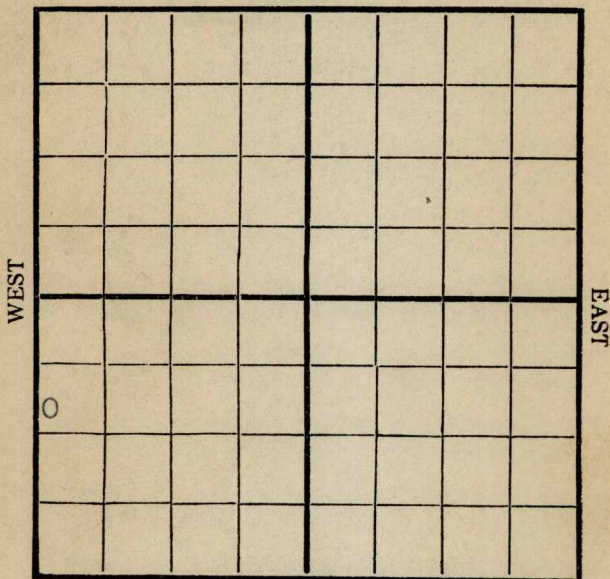

SOUTH

Location _____

Rig Up _____

Drilling and remarks

/ 1410 H.F. Water

RECORD

Cased _____ in. _____ Ft.

Sand _____

Gas _____

Oil _____

Total Depth _____

PRODUCTION

1st 24 hrs. Nat. _____

1st 24 hrs. after shot _____

Gas _____ Cu. Ft.

Dry Hole _____

Abandoned _____

Date

OCT 28 1916

191

E. H. WEST


Scout

Map No. Greenwood Sec. 8 Twp. 27 R. 9
 Well No. 1 Budler Farm _____
Beaumont Oil Company

NORTH

WEST

EAST

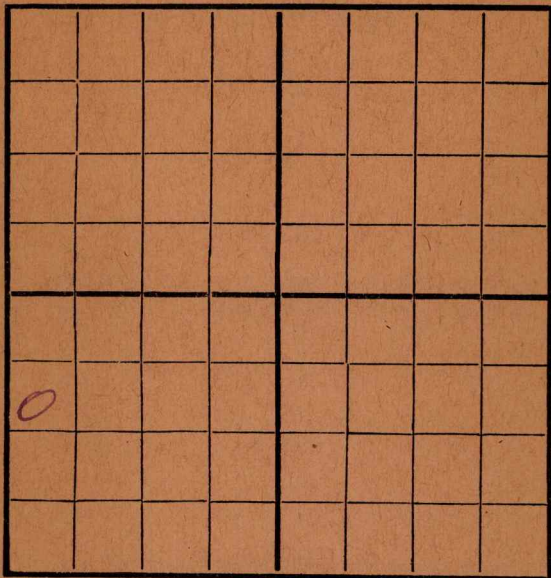

SOUTH

Location _____

Rig Up _____

Drilling and remarks

Fishing 1480

RECORD

Cased _____ in. _____ Ft.

Sand _____

Gas _____

Oil _____

Total Depth _____

PRODUCTION

1st 24 hrs. Nat. _____

1st 24 hrs. after shot _____

Gas _____ Cu. Ft.

Dry Hole _____

Abandoned _____

Date

11/4, 191 *6*,*E. H. WEST* Scout

GREENWOOD


Map No. _____ Sec. 8 Twp. 27 R. 9Well No. 1 Beedles Farm _____

Beaumont Oil Company

NORTH

WEST

EAST

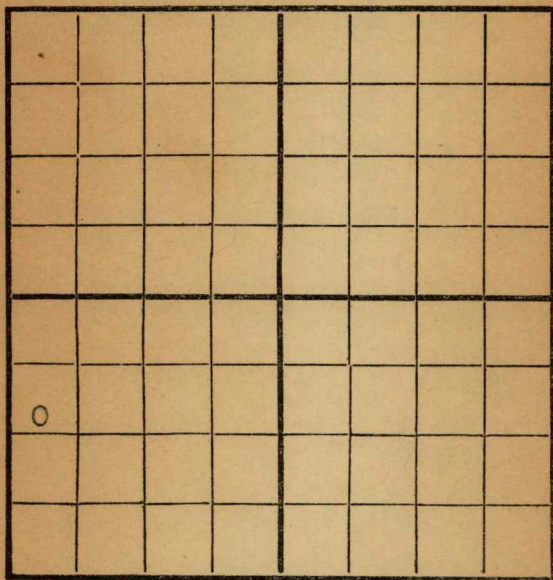

SOUTH

Location _____

Rig Up _____

Drilling and remarks

1505

RECORD

Cased _____ in. _____ Ft.

Sand _____

Gas _____

Oil _____

Total Depth _____

PRODUCTION

1st 24 hrs. Nat. _____

1st 24 hrs. after shot _____

Gas _____ Cu. Ft.

Dry Hole _____

Abandoned _____

Date

E. H. WEST

NOV 11 1916

191

Scout

RM 26-6-20-16-500 BOOK
GREENWOOD

Map No. _____ Sec. 8 Twp. 27 R. 9

Well No. 1 Beedles Farm
Beaumont Oil Company

NORTH

WEST

EAST

0

SOUTH

Location _____

Rig Up-----

Drilling and remarks

S.D.-1505 Fuel

RECORD

Cased-----in. -----Ft.

Sand-----

Gas _____

Oil _____

Total Depth_____

PRODUCTION

1st 24 hrs. Nat.

1st 24 hrs. after shot-----

Gas_____Cu. Ft.

Dry Hole_____

Abandoned.....

Date _____

Date NOV 18 1916

E. H. WEST

191


Scout

GREENWOODMap No. Sec. 8 Twp. 27 R. 9Well No. 1 Beedles FarmBeaumont Oil Company

NORTH

WEST

EAST

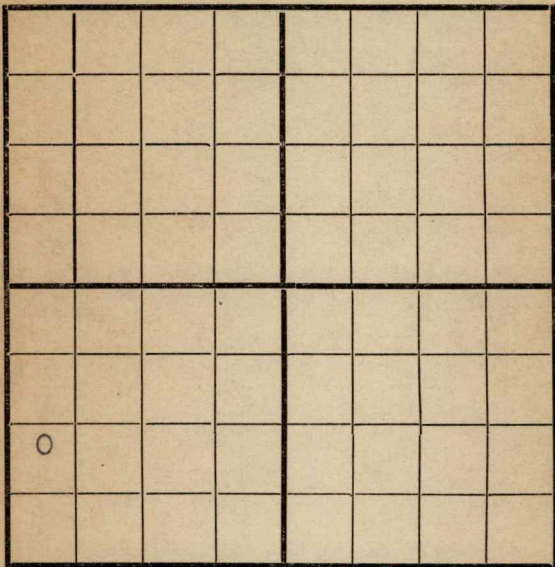

SOUTH

Location

Rig Up

Drilling and remarks

SD. 1505**RECORD**

Cased in. Ft.

Sand

Gas

Oil

Total Depth

PRODUCTION

1st 24 hrs. Nat.

1st 24 hrs. after shot

Gas Cu. Ft.

Dry Hole

Abandoned

Date

NOV 25 1916

191

E. H. WEST

Scout

GREENWOOD

Map No. _____ Sec. 8 Twp. 27 R. 9

Well No. 1 Beedles Farm

Beaumont Oil Company

NORTH

WEST

EAST

0

SOUTH

Location _____

Rig Up _____

Drilling and remarks

SD-1975 fuel

RECORD

Cased _____ in. _____ Ft.

Sand _____

Gas _____

Oil _____

Total Depth _____

PRODUCTION

1st 24 hrs. Nat. _____

1st 24 hrs. after shot _____

Gas _____ Cu. Ft.

Dry Hole _____

Abandoned _____

Date

DEC - 2 1916

191

E. H. WEST

Scout


GREENWOOD

Map No. _____ Sec. 8 Twp. 27 R. 9
 Well No. 1 Beedles Farm _____
Beaumont Oil Company

NORTH

WEST

EAST

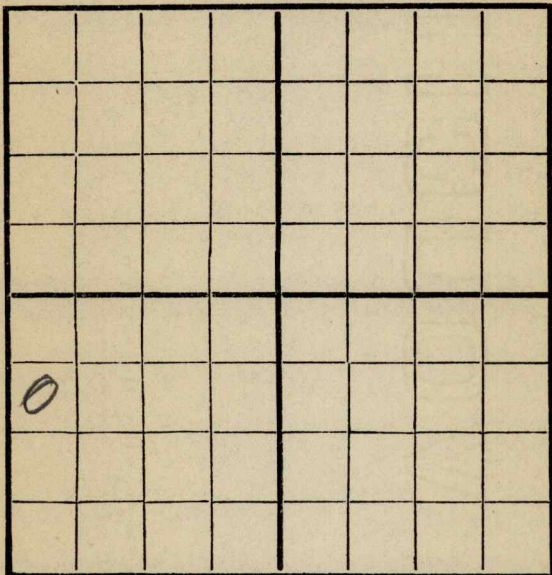

SOUTH

Location _____

Rig Up _____

Drilling and remarks

SN-1975
fuel

RECORD

Cased _____ in. _____ Ft.

Sand _____

Gas _____

Oil _____

Total Depth _____

PRODUCTION

1st 24 hrs. Nat. _____

1st 24 hrs. after shot _____

Gas _____ Cu. Ft.

Dry Hole _____

Abandoned _____

Date

DEC - 9 1916

E. H. WEST

191


Scout

Map No. Sec. 8 Twp. 27 R. 9
 Well No. 1 Beedle Farm
Beaumont Oil Co. Company

NORTH

WEST

EAST

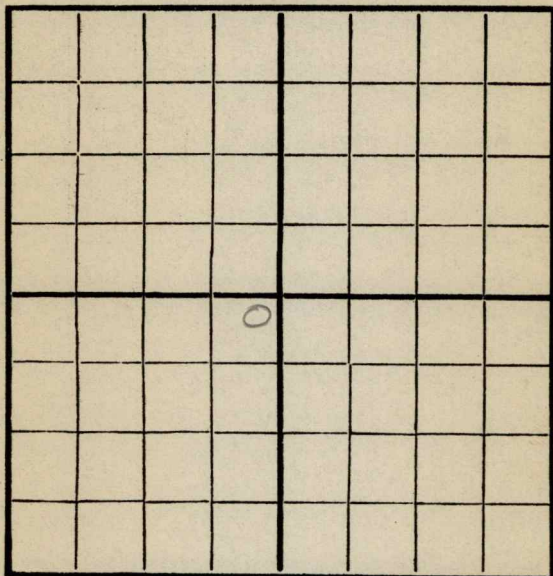

SOUTH

Location
 Rig Up
 Drilling and remarks

2050 SD.
in fuel

RECORD

Cased in. Ft.
 Sand
 Gas
 Oil
 Total Depth


PRODUCTION

1st 24 hrs. Nat.
 1st 24 hrs. after shot
 Gas Cu. Ft.
 Dry Hole
 Abandoned

Date

12/14, 1916, Wulfrid Scout

Map No. _____ Sec. 8 Twp. 27 R. 9
 Well No. 1 Biddle Farm _____
Beaumont Oil & Gas Company

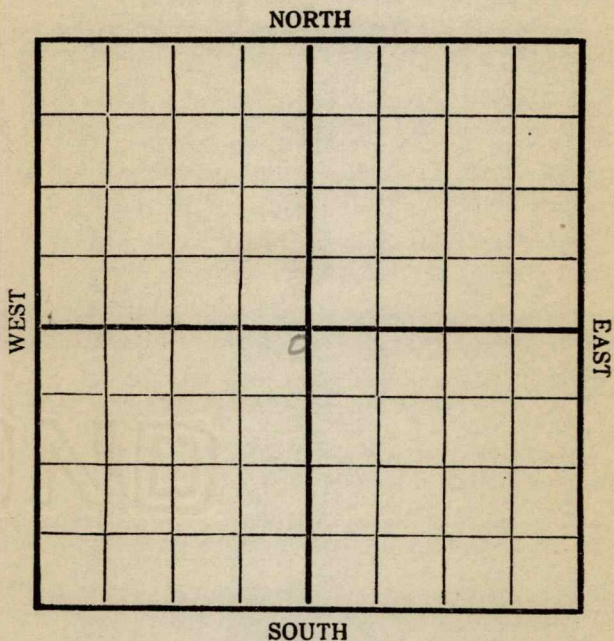

	RECORD
Location _____	Cased _____ in. _____ Ft.
Rig Up _____	Sand _____
Drilling and remarks	Gas _____
<u>S.I. 2050</u>	Oil _____
<u>no funds,</u>	Total Depth _____
	PRODUCTION
	1st 24 hrs. Nat. _____
	1st 24 hrs. after shot _____
	Gas _____ Cu. Ft.
	Dry Hole _____
	Abandoned _____


Date 12/22, 1916 W. Milford Scout

GREENWOOD COUNTY

Map No. _____ Sec. 8 Twp. 27 R. 9
 Well No. 1 Boodle Farm _____
Beaumont O & G Company _____

NORTH

WEST

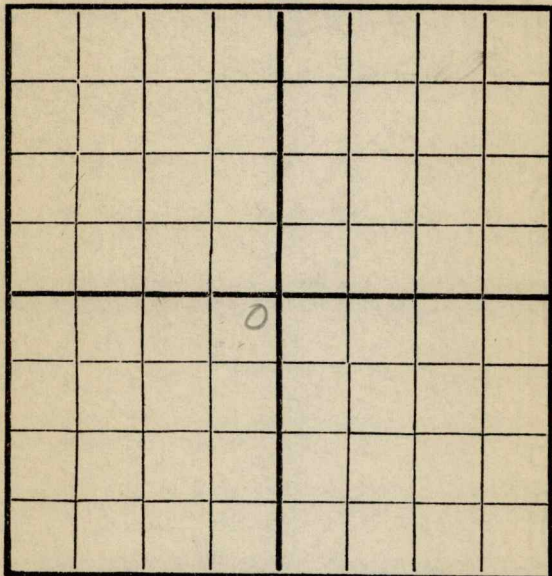

EAST

SOUTH

Location _____

Rig Up _____

Drilling and remarks

511. 2050No funds.

RECORD

Cased _____ in. _____ Ft.

Sand _____

Gas _____

Oil _____

Total Depth _____

PRODUCTION

1st 24 hrs. Nat. _____

1st 24 hrs. after shot _____

Gas _____ Cu. Ft.

Dry Hole _____

Abandoned _____

Date


12/25, 1916, Welford Scout

Map No. _____ Sec. T Twp. 27 R. 9
 Well No. 1 Beedle Farm _____
Beaumont Oil Co. Company _____

NORTH

WEST

EAST

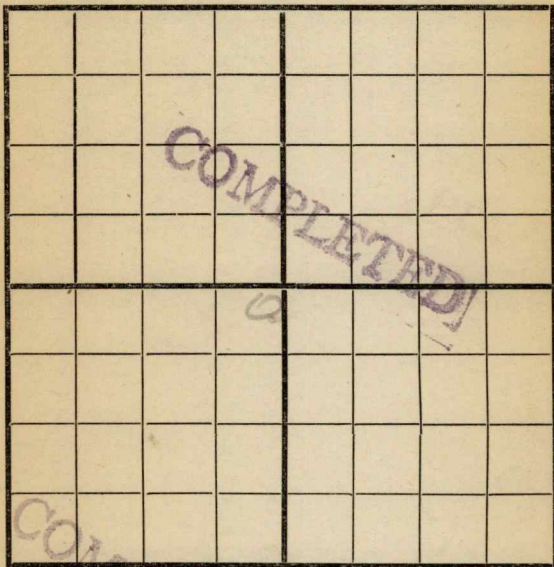

SOUTH

Location _____

Rig Up _____

Drilling and remarks

RECORD

Cased _____ in. _____ Ft.

Sand _____

Gas _____

Oil _____

Total Depth _____

PRODUCTION

1st 24 hrs. Nat. _____

1st 24 hrs. after shot _____

Gas _____ Cu. Ft.

Dry Hole _____

Abandoned _____


Date

1/4, 1917 Mulford Scout

Map No. Kurs Sec. 8 Twp. 27 R. 9
 Well No. Beedale Farm
Beaumont O. Company

NORTH

WEST

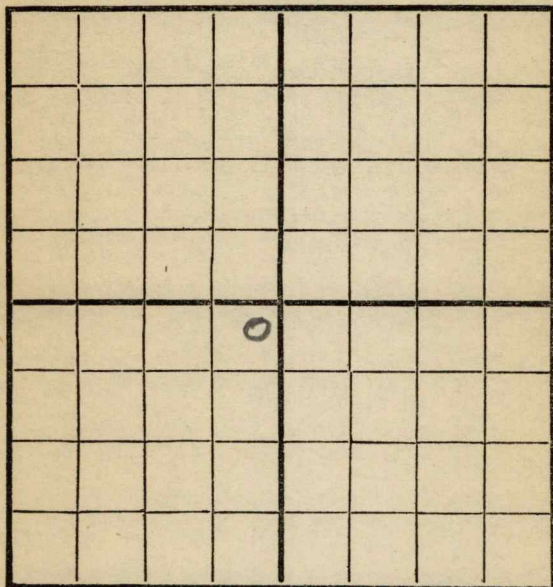

EAST

SOUTH

Location _____

Rig Up _____

Drilling and remarks

3/21/17 - 2500
S.D.

RECORD

Cased _____ in. _____ Ft.

Sand _____

Gas _____

Oil _____

Total Depth _____

PRODUCTION

1st 24 hrs. Nat. _____

1st 24 hrs. after shot _____

Gas _____ Cu. Ft.

Dry Hole _____

Abandoned _____


Date

3/24, 191 7 Philip T. Gast Scout

Map No. _____ Sec. 8 Twp. 27 R. 9
 Well No. Beedle Farm _____
Braumont Oil Company _____

NORTH

WEST

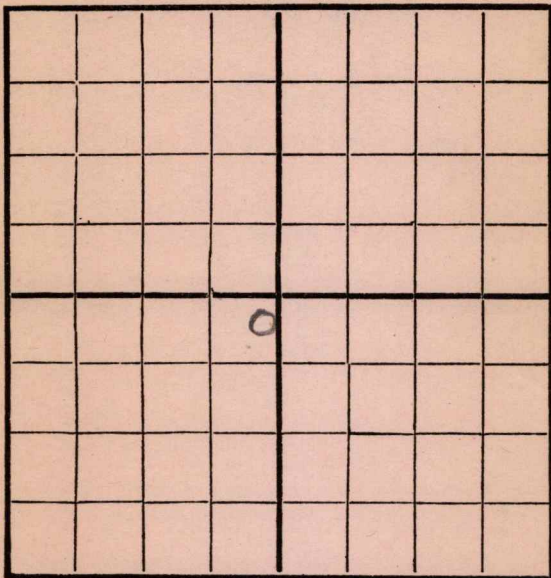

EAST

SOUTH

RECORD

Location _____

Rig Up _____

Drilling and remarks

4/5/172539'

Cased _____ in. _____ Ft.

Sand _____

Gas _____

Oil _____

Total Depth _____

PRODUCTION

1st 24 hrs. Nat. _____

1st 24 hrs. after shot _____

Gas _____ Cu. Ft.

Dry Hole _____

Abandoned _____

Date

4/5, 1917 Philip L. Gast Scout


Map No. K10 Sec. 8 Twp. 27 R. 9Well No. 1 BiddleBeaumont O & G. Company

Contractor

NORTH

WEST

EAST

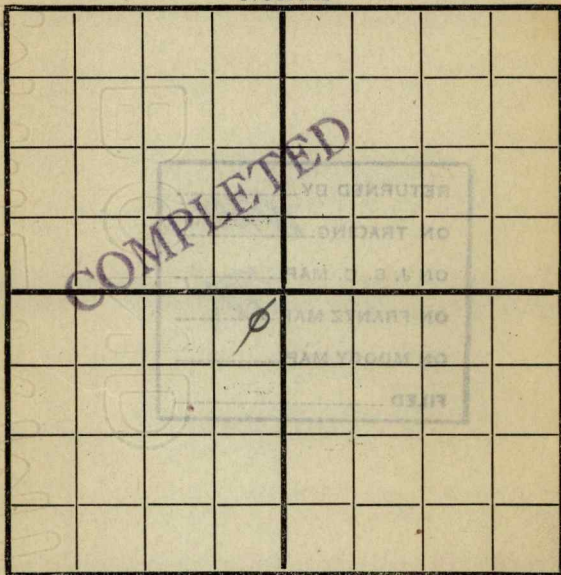

SOUTH

Location _____

Rig up _____

Drilling and Remarks:

RECORD

Cased _____ in., _____ ft.

Sand _____

Gas _____

Oil _____

Total Depth _____

PRODUCTION

1st 24 hrs. Nat. _____

1st 24 hrs. after shot _____

Gas _____ Cu. Ft.

Dry Hole 2670 _____

Abandoned _____

Date

7/15 8 Dry Scout