


Section 6 Township 19 Range 1W

Well No. 3 Russell

Company Bay Pet.

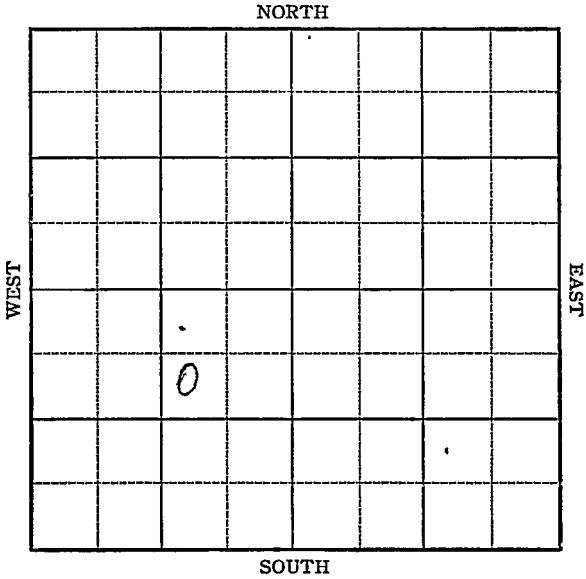

Sec. 6 Twp. 19 R. 1W

Well No. 3 Russell Farm


Bay Pet. _____ Company

Jenday
-990 Ft. from N. Line

_____ Ft. from S. Line

990 Ft. from E. Line

_____ Ft. from W. Line

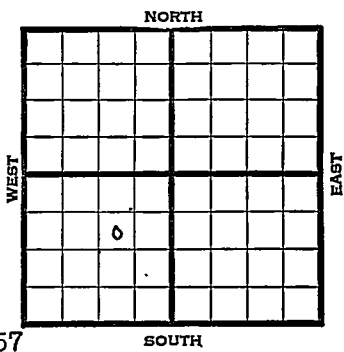

SW NE SW Elev. 1557

1945 REPORT

5/16 Location
 5/24 8" @ 182
 Drlg. 1400
 5/31 Drlg. 2954
 6/8 2954 SD
 6/14 Lams 2312
 Miss 2915
 TD 2945
 5" @ 2951 RUST
 6/21 TD 2962
 7 gal oil PH
 6/28 " "
 7/3 TD 2962
 7 gals. oil per hr.
 7/11 " " " " "
 7/18 Miss. 2925
 5" @ 2951
 TD 2962
 Pump 80 Pot.
 Grav. 36.0

COMPLETED

Kansas Pool Name Jenday

Map No. 43 Sec. 6 Twp. 19 R. 1W

Well No. 3 Russell

Bay Pet Company

FIRST REPORT

Contractor

SW NE SW

SECTION PLAT

990 Ft. from N. Line

_____ Ft. from S. Line

990 Ft. from E. Line

_____ Ft. from W. Line

McPherson

Location X

Rig up _____

Drilling and Remarks:

RECORD

Cased _____ in., _____ ft.

Sand _____

Gas _____

Oil _____

Total Depth _____

PRODUCTION

1st 24 hrs. Nat. _____

1st 24 hrs. after shot _____

Gas _____ Cu. Ft.

Dry Hole _____

Abandoned _____

Date

MAY 16 1945

19

S. J. LEWIS

Scout

KANSAS Kansas Pool Name Jenday

Map No. 43 Sec. 6 Twp. 19 R. 1W

Well No. 3 Russell

Bay Pet. Company

COMPLETED

Contractor

SW NE SW

E/11557
SECTION PLAT

990 Ft. from N. Line

 Ft. from S. Line

990 Ft. from E. Line

 Ft. from W. Line

	6		

McPher son County

Location _____

Rig up _____

Drilling and Remarks:

Miss 2925
5" @ 2951
Pump to RT

36 - 3/4

RECORD

Cased _____ in., _____ ft.

Sand _____

Gas _____

Oil _____

Total Depth 2962

PRODUCTION

1st 24 hrs. Nat. _____

1st 24 hrs. after shot _____

Gas _____ Cu. Ft.

Dry Hole _____

Abandoned _____

Date

JUL 1 8 1945

19

S. J. LEWIS

Scout