


Section 6 Township 19 Range 1W

Well No. 3 Ryno

Company Bay Pet.

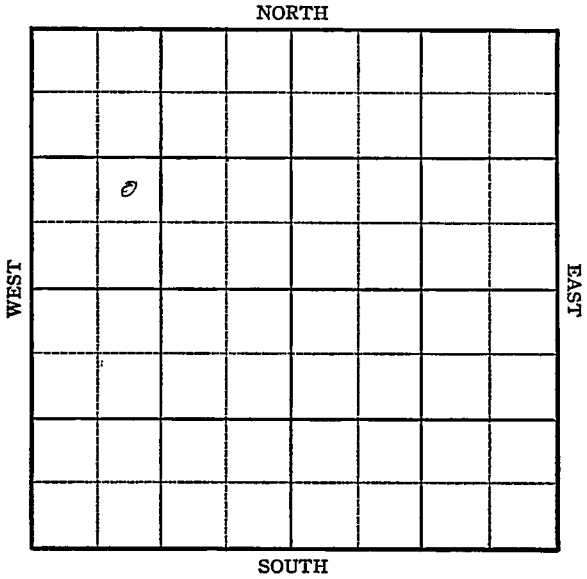

Sec. 6 Twp. 19 R. 1-W

Well No. #3 Ryno Farm


Bay Pet. Company

_____ Ft. from N. Line

990 Ft. from S. Line

_____ Ft. from E. Line

990 Ft. from W. Line

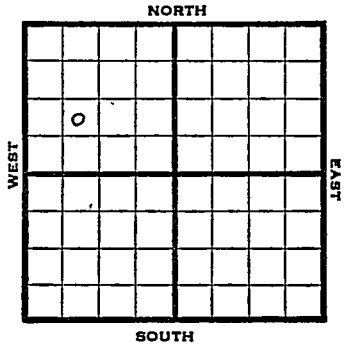

NE SW NW

1945 Elev. 1544' REPORT

11/21 8" @ 155'
T.D. 950'

11/28 Lans. 2303
Miss. 2905
TD 2939

12/5 5" @ 2933 RUST
TD 2957

12/12 500 acid

12/19 Miss. 2905
5" @ 2933
500 acid.
TD 2957
Pump 129 oil plus 29% W. Pot.
Grav. 36.0

COMPLETED

KANSASKansas Pool Name JendayMap No. 43 Sec. 6 Twp. 19 R. 1WWell No. 3 Ryno

Bay Pet. _____ Company _____

FIRST REPORT

Contractor _____

NE SW NW

_____ Ft. from N. Line

990 Ft. from S. Line

_____ Ft. from E. Line

990 Ft. from W. Line**SECTION PLAT**

o			
	.		

McPherson County

Location _____

Rig up _____

Drilling and Remarks:

8" @ 155

950'

RECORD

Cased _____ in., _____ ft.

Sand _____

Gas _____

Oil _____

Total Depth _____

PRODUCTION

1st 24 hrs. Nat. _____

1st 24 hrs. after shot _____

Gas _____ Cu. Ft.

Dry Hole _____

Abandoned _____

Date

NOV 21 1945 19 _____S. J. LEWIS Scout

