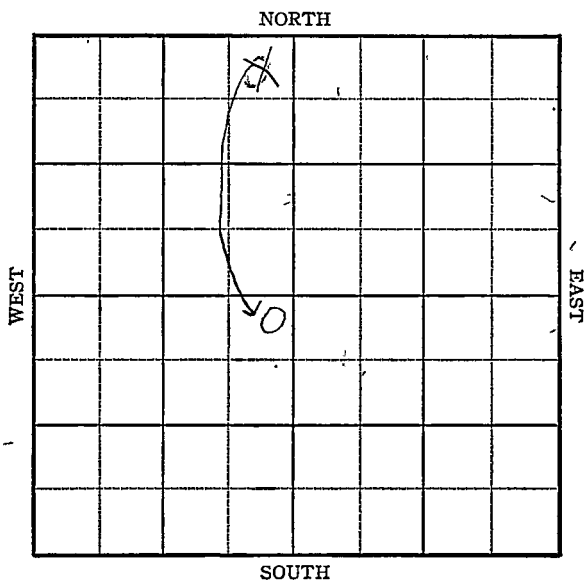


Section 6 Township 19 Range 7WWell No. 4 RussellCompany Bay Pet.

KANSAS

McPherson

Sec. 6 Twp. 19 R. 1-W

Well No. #4 Russell Farm

Bay Pet. Company


Monday

330 Ft. from N. Line

Ft. from S. Line

330 Ft. from E. Line

Ft. from W. Line

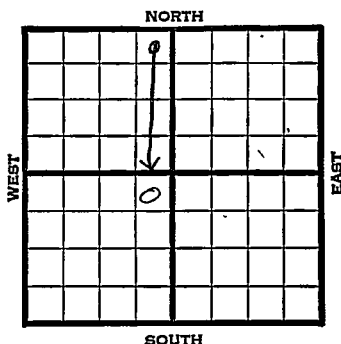

~~NE NW~~ NE SW

1945

Elev. 1567

REPORT

7/3

Location

7/11

8" @ 185' WOC

7/19

Lans 2323

Miss. 2938

5" @ 2955

2956 TD RUST

7/26

" " "

8/1

TD 2969 1000 acid.

Swab 25 oil day

8/8

" " "

8/15

" " "

8/22

" " "

8/29

" " "

9/5

" " "

9/12

Miss. 2938

5" @ 2955

1000 acid.

TD 2969'

Pump 358 Pot.


Grav. 36.0

COMPLETED

KANSASPool Name JendayMap No. 43 Sec. 6 Twp. 19 R. 1WWell No. 4 RussellBay Pet. CompanyFIRST REPORT Contractor

NE NW

SECTION PLAT

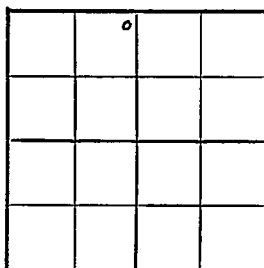330 Ft. from N. Line Ft. from S. Line330 Ft. from E. Line Ft. from W. LineMcPherson CountyLocation XRig up

Drilling and Remarks:

RECORD

Cased in., ft.Sand Gas Oil Total Depth

PRODUCTION

1st 24 hrs. Nat. 1st 24 hrs. after shot Gas Cu. Ft.Dry Hole Abandoned

Date

JUL 3 1945 19 S. J. LEWIS Scout

Kansas Pool Name JendayMap No. 43 Sec. 6 Twp. 19 R. 1WWell No. 4 Russell

Bay Pet.


Company

CORRECTION

Contractor

NE SW

SECTION PLAT

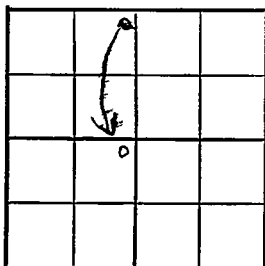330 Ft. from N. Line Ft. from S. Line330 Ft. from E. Line Ft. from W. Line

McPherson County

Location Rig up

Drilling and Remarks:

reported NE NW

RECORD

Cased in., ft.Sand Gas Oil Total Depth

PRODUCTION

1st 24 hrs. Nat. 1st 24 hrs. after shot Gas Cu. Ft.Dry Hole Abandoned

Date

/

JUL 11 1945

19

S. J. LEWIS

Scout

KANSAS Kansas Pool Name JendayMap No. 43 Sec. 6 Twp. 19 R. 1WWell No. 4 Russell

Bay Pet. _____ Company _____

COMPLETED

Contractor _____


NE SW

E1167
SECTION PLAT330 Ft. from N. Line

_____ Ft. from S. Line

330 Ft. from E. Line

_____ Ft. from W. Line

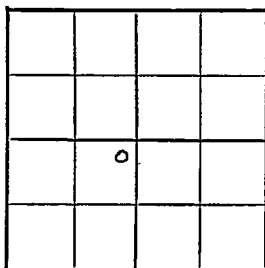

McPherson County

Location _____

Rig up _____

Drilling and Remarks:

*Miss 2938**5" 2955**1000 acud**Pump 3058 P**36 1/2*

RECORD

Cased _____ in., _____ ft.

Sand _____

Gas _____

Oil _____

Total Depth 2968

PRODUCTION

1st 24 hrs. Nat. _____

1st 24 hrs. after shot _____

Gas _____ Cu. Ft.

Dry Hole _____

Abandoned _____

Date

SEP 12 1945

19

S. J. LEWIS Scout