


SECTION 9 TOWNSHIP 19 RANGE 1W

WELL NO. #1 Carpenter

COMPANY Greenland Drlg.

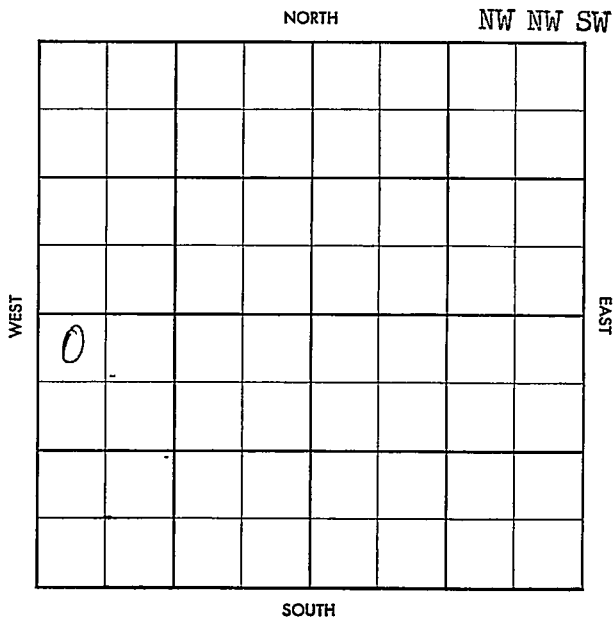

WILDCAT

FORM 513 SUNRAY

County McPherson Elev. _____
Sec. 9 Twp. 19 Rge. 1W
Company Greenland Drlg.
Farm Name Carpenter No. 1

TOPS	DEPTH	LOG	DATUM	Loc. in Sec.
Anh.				NW NW SW
Tp.				
H.				
Tr.				
Dg.				
Bl.				
L.				Geol. _____
K.C.				Contr. _____
B.K.C.				Co. Tools _____
Ce.				Pool _____
C.				Wildcat
M.				
M.				
K.				
Mz.				
Mo.				
V.				
S.				
S.				
A.				
R.				
Pe.				
G.				
T.D.				

FIRST REPORT
MAY 29 '57

Date Comm. _____
Location _____

Co.

County McNernson Elev. 1582
 Sec. 9 Twp. 19 Rge. W
 Company Greenland Drilling
 FarmName Carpenter No. 1

TOPS	DEPTH	LOG	DATUM
Anh.			
Tp.			
H.			
Tr.			
Dg.			
Bl.	<u>2287</u>		
L.	<u>2346</u>		
K.C.			
B.K.C.			
Ce.			
C.			
M.	<u>2936</u>		
M.			
K.			
Mz.			
Ma.			
V.			
S.			
S.			
A.			
R.			
Pe.			
G.			
T.D.	<u>3000</u>		

Loc. in Sec. _____

NW NW SW

Geol. _____

Contr. _____

Co. Tools

Pool _____

wildcat

ABANDONED

0

JUN 5 '57

Lse.

No.

Sec.

T.

R.

Date Comm. _____

Location JUN 5 '57 5-29-57 85/8
159 DST 2964-3000 1hr
see 900' SW + 550 no BHP

D E W