


21

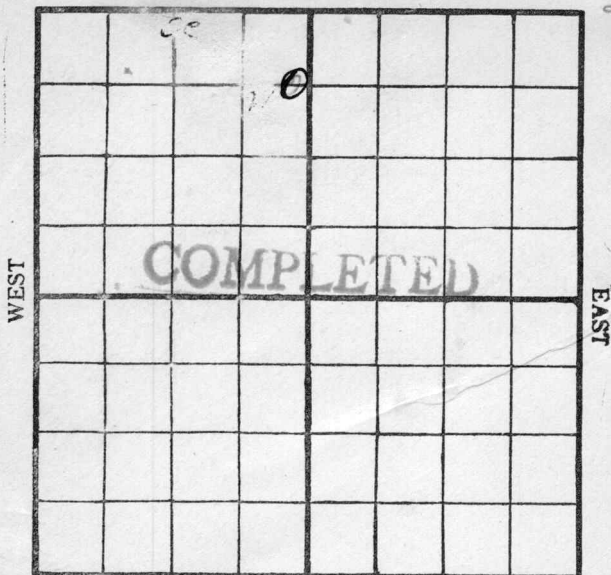

SOUTH

Rig Up-----

Drilling Remarks:

PRODUCTION

1st 24 hrs. Nat.-----

1st 24 hrs. after shot-----


Gas_____cu. ft

Dry Hole_____

Abandoned -----

Map No. _____ Sec. 11 Twp. 27 R. 5
 Well No. 3 Hunter Farm _____
Trux & Hale Company _____

NORTH

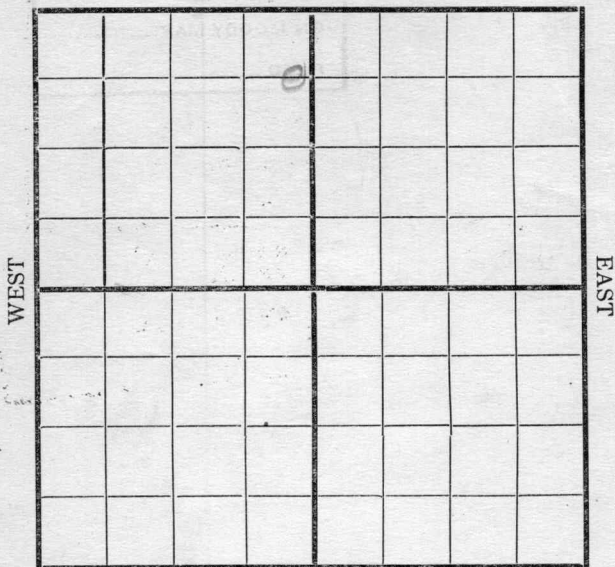

SOUTH

Location _____
 Rig Up ☒ _____
 Drilling and remarks _____

RECORD

Cased _____ in. _____ Ft.
 Sand _____
 Gas _____
 Oil _____
 Total Depth _____

PRODUCTION

1st 24 hrs. Nat. _____
 1st 24 hrs. after shot _____
 Gas _____ Cu. Ft.
 Dry Hole _____
 Abandoned _____


FIRST REPORT

Date 7/6, 1917 Quincy Scout

Map No. _____ Sec. 11 Twp. 27 R. 5
 Well No. 3 Knutson Farm
James & Hall Company

NORTH

WEST

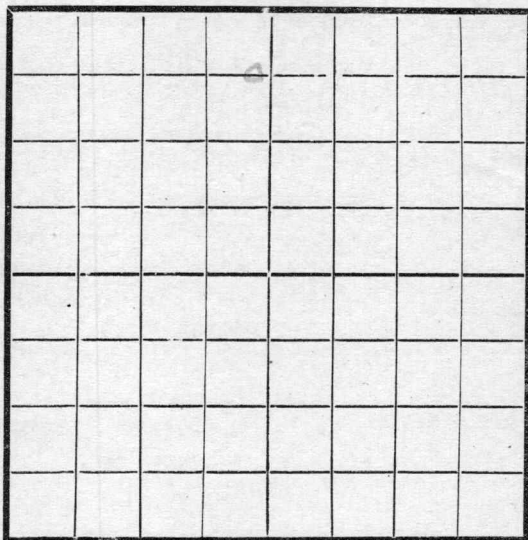

EAST

SOUTH

Location _____
 Rig Up ✓ _____
 Drilling and remarks _____

RECORD

Cased _____ in. _____ Ft.
 Sand _____
 Gas _____
 Oil _____
 Total Depth _____

PRODUCTION

1st 24 hrs. Nat. _____
 1st 24 hrs. after shot _____
 Gas _____ Cu. Ft.
 Dry Hole _____
 Abandoned _____

Date

7/12, 1917 C. G. Giff Scout


Map No. _____ Sec. 11 Twp. 22 R. 5

Well No. 3 Farm _____

Knox & Hale Company _____

NORTH

WEST

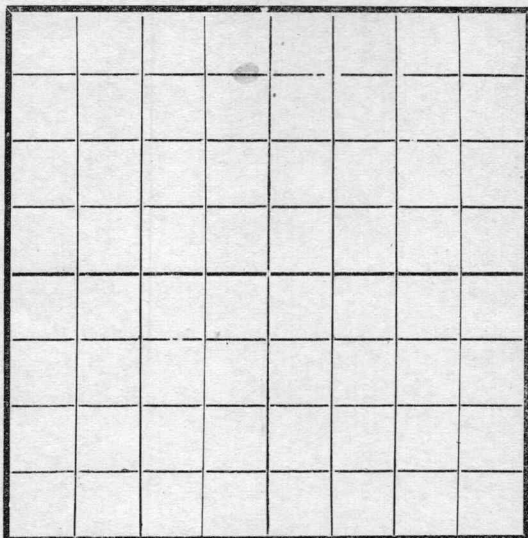

EAST

SOUTH

Location _____

Rig Up _____

Drilling and remarks

130

RECORD

Cased _____ in. _____ Ft.

Sand _____

Gas _____

Oil _____

Total Depth _____

PRODUCTION

1st 24 hrs. Nat. _____

1st 24 hrs. after shot _____

Gas _____ Cu. Ft.

Dry Hole _____

Abandoned _____


Date

7/7, 1917 Candey Scout

Map No. _____ Sec. 11 Twp. 27 R. 5Well No. 3 Kuntz FarmKnox & Kelp Company

NORTH

WEST

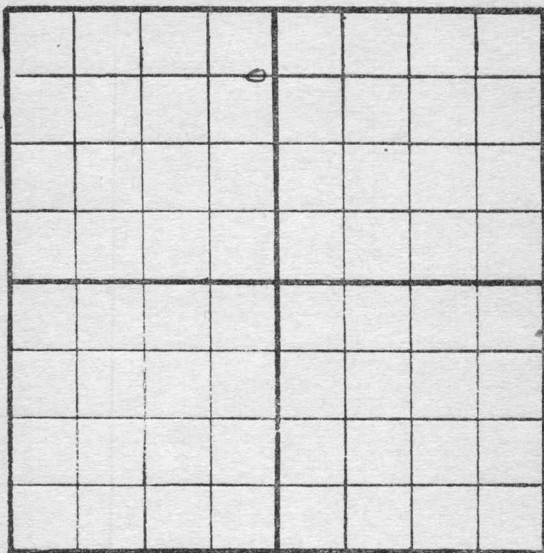

EAST

SOUTH

Location _____

Rig up _____

Drilling and remarks:

675

RECORD

Cased _____ in. _____ Ft.

Sand _____

Gas _____

Oil _____

Total Depth _____

PRODUCTION

1st. 24 hrs. Nat. _____

1st. 24 hrs. after shot _____

Gas _____ Cu. Ft.

Dry Hole _____

Abandoned _____

Date

7/24, 1917, Condiff Scout

Map No. _____ Sec. 11 Twp. 27 R. 5
 Well No. 3 Kuntson Farm
Kuntson & Co. Company

NORTH

WEST

EAST

SOUTH

RECORD

Location _____

Rig up _____

Drilling and Remarks:

1225

Cased _____ in. _____ Ft.

Sand _____

Gas _____

Oil _____

Total Depth _____

PRODUCTION

1st 24 hrs. Nat. _____

1st 24 hrs. after shot _____

Gas _____ Cu. Ft.

Dry Hole _____

Abandoned _____


Date

8/1, 1917, Cordell Scout

Map No. _____ Sec. 11 Twp. 27 R. 3Well No. 3 Farm Kennel
Kennel & Hall Company

NORTH

WEST

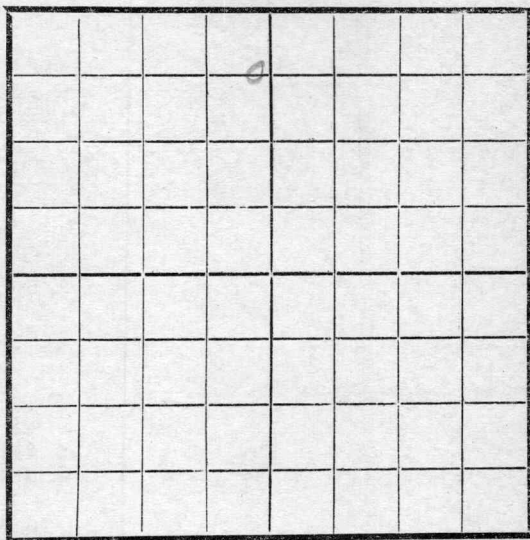

EAST

SOUTH

Location _____

Rig Up _____

Drilling and remarks
2000

RECORD

Cased _____ in. _____ Ft.

Sand _____

Gas _____

Oil _____

Total Depth _____

PRODUCTION

1st 24 hrs. Nat. _____

1st 24 hrs. after shot _____

Gas _____ Cu. Ft.

Dry Hole _____

Abandoned _____


Date

8/18, 1917 Cumley Scout

Map No. _____ Sec. 11 Twp. 27 R. 5
 Well No. 3. Knutsen Farm
Knock & Hole Company

NORTH

WEST

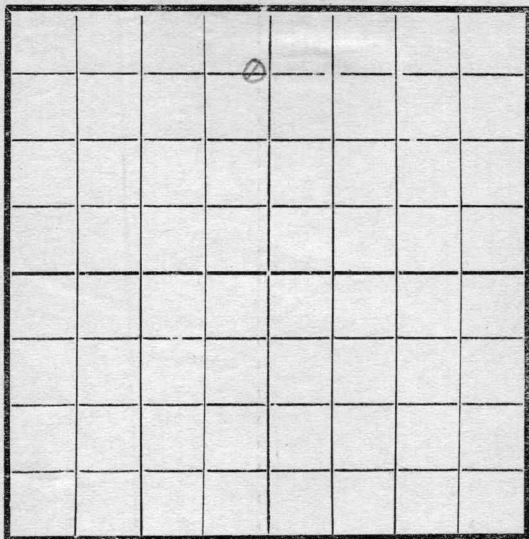

EAST

SOUTH

Location _____

Rig Up _____

Drilling and remarks

at 2570

RECORD

Cased _____ in. _____ Ft.

Sand _____

Gas _____

Oil _____

Total Depth _____

PRODUCTION

1st 24 hrs. Nat. _____

1st 24 hrs. after shot _____

Gas _____ Cu. Ft.

Dry Hole _____

Abandoned _____


Date

8-21, 1917Lantz Scout

Map No. 111 Sec. 11 Twp. 22 R. 5Well No. 4 Trintson Farm
Knox & Sons Company

NORTH

WEST

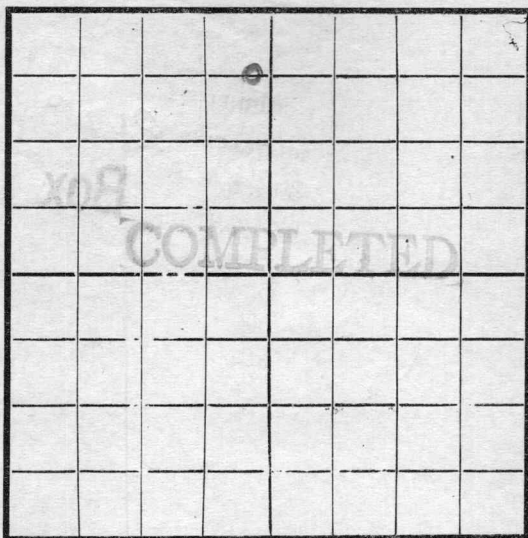

EAST

SOUTH

Location -----

Rig Up -----

Drilling and remarks

Est at
75 Bbls

RECORD

Cased ----- in. ----- Ft.

Sand 2700-2721

Gas -----

Oil -----

Total Depth -----

PRODUCTION

1st 24 hrs. Nat. -----

1st 24 hrs. after shot -----

Gas ----- Cu. Ft.

Dry Hole -----


Abandoned -----

Date

9/5, 1917 Candiff Scout

Map No. _____ Sec. 11 Twp. 27 R. 5
 Well No. 37 Trintson Farm
Knox & Hall Company

NORTH

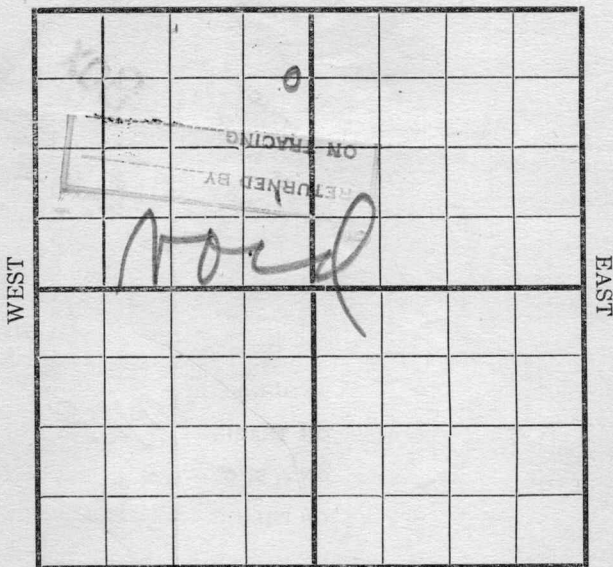

SOUTH

Location _____

Rig Up _____

Drilling and remarks

*No this
 well change
 from 3
 to 4*

RECORD

Cased _____ in. _____ Ft.

Sand _____

Gas _____

Oil _____

Total Depth _____

PRODUCTION

1st 24 hrs. Nat. _____

1st 24 hrs. after shot _____

Gas _____ Cu. Ft.

Dry Hole _____

Abandoned _____

Date

9/5, 1917 Candiff Scout