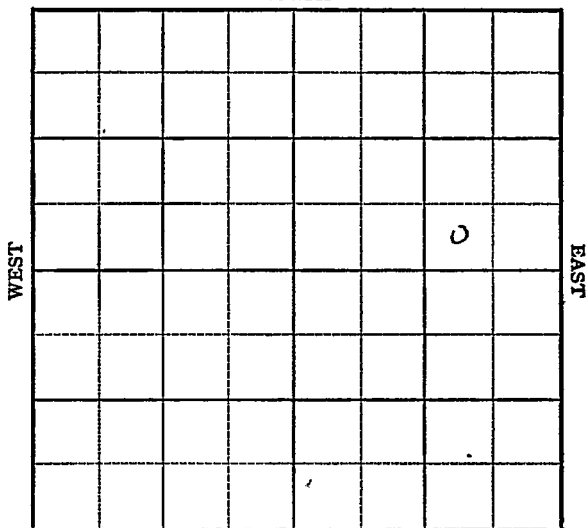


KANSAS

McPherson

Section 7 Township 19 Range 1WWell No. 7 Wedel "B"Company Barbara OilBitikofer
NORTH

SOUTH

KANSAS

McPherson

Sec. 7 Twp. 19 R. 1W ✓Well No. #7 Wedel "B" Farm

Barbara Oil Company


Bitikofer

_____ Ft. from N. Line

330' Ft. from S. Line990' Ft. from E. Line

_____ Ft. from W. Line

SW SE NE

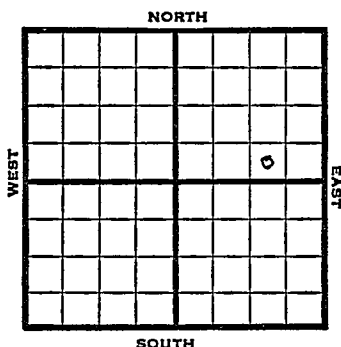1949 ^Elev 1577' REPORT

Location

2/9 2/16 2/23 3/2 3/8 3/16 3/23 3/30 4/6 4/12 4/20 4/27 5/4 5/10 5/18 5/25	8" @ 142' Drlg. 860' Miss 2969-73' TD 2973' 5" @ 2972' " " " " " " " TD 2990' 4½ B Wtr / 4 B Oil 12 hrs. PB 2980' 2000 acid Pump 3 bbls oil 15 W in 12 hrs. " " " " TD 2990' Miss 2969' 5" @ 2972' 2000 acid Pump 3 Oil / 8 W Pot 380 Gr. Comp
---	---

COMPLETED

Bitkofer

Map No. _____ Sec. 7 Twp. 19 R. 1 W

Well No. 7 Wedel "B"

Barbora Oil Company

FIRST REPORT

Contractor
SWSENE

SECTION PLAT

_____ Ft. from N. Line

530 Ft. from S. Line

490 Ft. from E. Line

_____ Ft. from W. Line

McPherson

Location ✓

Rig up _____

Drilling and Remarks:

RECORD

Cased _____ in., _____ ft.

Sand _____

Gas _____

Oil _____

Total Depth _____

PRODUCTION

1st 24 hrs. Nat. _____

1st 24 hrs. after shot _____

Gas _____ Cu. Ft.

Dry Hole _____

Abandoned _____

Date

FEB 9 1949 19

S. J. LEWIS

Scout

Kansas

Bitikofer Pool

Map No. K 43 Sec. 7 Twp. 19 R. 1WWell No. 7 Wedel "B"Barbara Oil

Company

COMPLETE

Contractor

SW SE NE

E 1, 1577
SECTION PLAT Ft. from N. Line330 Ft. from S. Line990 Ft. from E. Line Ft. from W. LineMcPherson County

Location Rig up

Drilling and Remarks:

Misc 2969
5" C 2972
2000 acid
Pump. soil + 8W/88

*38° S***RECORD**Cased in., ft.Sand Gas Oil Total Depth 2996**PRODUCTION**1st 24 hrs. Nat. 1st 24 hrs. after shot Gas Cu. Ft.Dry Hole Abandoned

Date

MAY 25 1949 19S. J. LEWIS

Scout