

Elk

KANSAS


Form 51-5M 5-37 Petrol

Section 3 Township 31 Range 8-E

Well No. #7 Denton

Company Murphy Oil

NORTH (Twin dry hole)

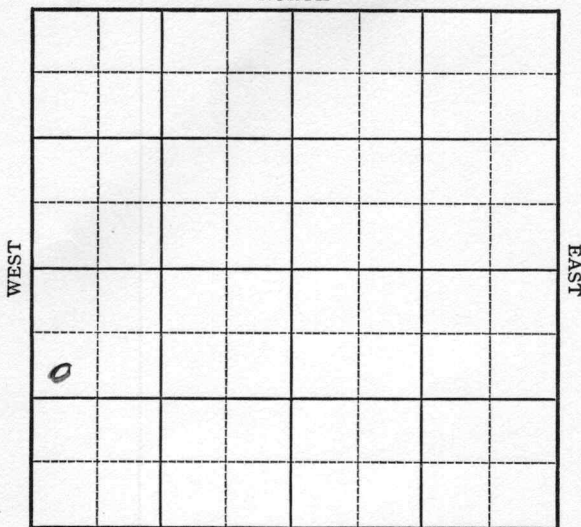

SOUTH


KANSAS

Elk

Sec. 3 Twp. 31 R. 8-EWell No. #7 Denton (Twin to Dry hole) FarmMurphy Oil Company1010 Ft. from N. Line

_____ Ft. from S. Line

_____ Ft. from E. Line

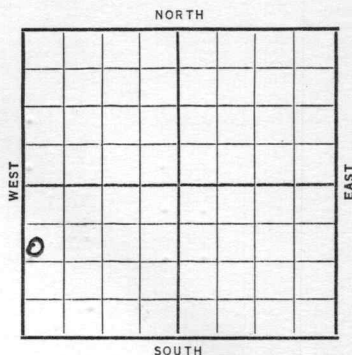100 Ft. from W. Line

Date	REPORT
1937	
10/13	10" @ 1420'.
	6" @ 2240'.
10/29	SD 2600'.
11/5	" "
11/12	" "
11/19	" "
11/26	" "
12/3	8" @ 1956'. K.C. 1958'.
	S.O. & G 1972-80'. Miss. 2665'.
	S.O. 2683-89'. 1800' oil in
	24 hrs @ 2693-2700'.
	Sil. 3114'. T.D. 3134'. H.F.W.
	P.B. to Miss.
12/10	" " "
12/17	" " "
12/24	" " "
12/31	" " "
1938	
1/7	" " "
	OVER

1938

1/12

6" @ 2716'.

Arb. 3114'.

T.D. 3134' H.F.W.

P.B. 2700'.

13 bbls. oil per day.

COMPLETED

Elk

KANSAS

Map No. 3 Sec. 3 Twp. 31 R. 8EWell No. 7 Denton(Twin To Dry hole)Murphy Oil

Company

Contractor

FIRST REPORT

SW NW SW

1010 Ft. from N. Line

_____ Ft. from S. Line

_____ Ft. from E. Line

100 Ft. from W. Line

SECTION PLAT

0			

Location _____

Rig up _____

Drilling and Remarks:

10-14206-2240

RECORD

Cased _____ in.; _____ ft.

Sand _____

Gas _____

Oil _____

Total Depth _____

PRODUCTION

1st 24 hrs. Nat. _____

1st 24 hrs. after shot _____

Gas _____ Cu. Ft.

Dry Hole _____

Abandoned _____

Date

OCT 13 1937

19

H. D. Hatfield

Scout

~~High~~

Sam- Our Tracing shows a #7
Dry Hole at this Location -
Pittman

Check advise above

This is a twin to dry
hole. The dry hole is
945' from north line.

Returned	~~Paul~~
Cards	~~Paul~~
Tracing	~~Paul~~
France Map	~~Paul~~
Scarborough	~~Paul~~
Moody Map	~~Paul~~
Scarborough Plat Book	~~Paul~~
Moody Plat Book	~~Paul~~

Elk

KANSAS

Map No. 3 Sec. 3 Twp. 31 R. 8EWell No. 7-A Denton (Twin)Murphy Oil Company

Contractor

COMPLETED

SW NW SW

1010 Ft. from N. Line Ft. from S. Line Ft. from E. Line100 Ft. from W. Line

SECTION PLAT

0			

Location Rig up

Drilling and Remarks:

P.B. 270013 bbls oil
per day

RECORD

Cased 6 in., 2716 ft.Sand Arb 3114Gas Oil Total Depth 3134PRODUCTION H.F.W.1st 24 hrs. Nat. 1st 24 hrs. after shot Gas Cu. Ft.Dry Hole Abandoned

Date

JAN 12 1938

19

H. D. Hatfield

Scout