

Rice


KANSAS

FORM 51 5M 10-41 PETROL

Section 19 Township 19 Range 10-W

Well No. #1 J. Doll

Company Cities Service Oil

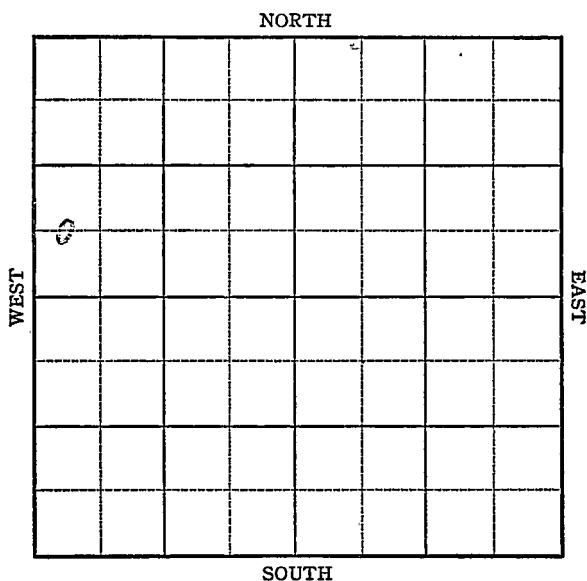

O. W. D. D

**KANSAS**

Rice

Sec. 19 Twp. 19 R. 10-W

Well No. #1 J. Doll Farm

Cities Service Oil Company

(Chase)


         Ft. from N. Line

660 Ft. from S. Line

         Ft. from E. Line

330 Ft. from W. Line

Elev. 1768

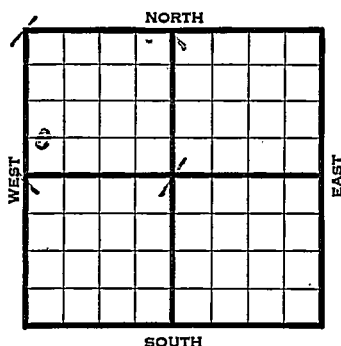

| 1941  | REPORT   |
|-------|---|
| 11/19 | Location   |
| 11/28 | 8" - 214' Drlg. 1995'                                                                                             |
| 12/4  | Lans. 3002' Arb. 3326-65' T.D.<br>5" - 3190' RUST.                                                                |
| 12/11 | 78 shots 3107-14 -5W per hr.<br>10 hrs. S. D.                                                                     |
|       | PB 3160   |
| 12/18 | PB 3088   |
| 12/24 | P.B. to 3093' 36 shots 3030-41'<br>1000 acid. 3,047,000 cu. ft. gas.                                              |
| 12/30 | Lans. 3002 Arb. 3326<br>5" @ 3190<br>TD 3365<br>PB 3093<br>36 shots 3030-41<br>1000 acid<br>3,047,000 cu. ft. gas |
|       | COMPLETED   |

OVER

O. W. D. D

O. W. D. D

1950

2/22    Lans 3002'  
         Cong 3302'  
         Arb. 3326'  
         TD 3665'  
         5"@ 3190'  
         6 shots 3098-3104  
         PB 3089  
         36 shots 3079-88 wtr squeezed off  
         Shot 3088-98 wtr.  
         PB 3065  
         36 shots 3015-54  
         1000 acid  
         open flow 1,000,000 cu ft per day  
         First Report & Comp

**FIRST REPORT**

✓  
**COMPLETED**

Map No. \_\_\_\_\_ Sec. 19 Twp. 19 R. 10W

Well No. 1 Doll "A"

Cities Service Company

Contractor

C W L SW NW

El. 1768


SECTION PLAT

\_\_\_\_\_ Ft. from N. Line

660 \_\_\_\_\_ Ft. from S. Line

\_\_\_\_\_ Ft. from E. Line

330 \_\_\_\_\_ Ft. from W. Line

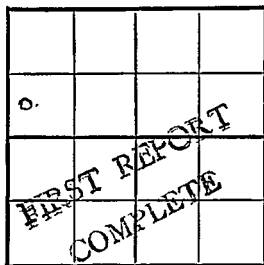

Rice County

Location \_\_\_\_\_

Rig up \_\_\_\_\_

Drilling and Remarks:

Lans. 3002

Cong. 3302

Arb. 3326

TD 3665

5" @ 3190

6 shots

3098-3104

PB 3089

RECORD

Cased \_\_\_\_\_ in., \_\_\_\_\_ ft.

Sand \_\_\_\_\_

Gas \_\_\_\_\_

Oil \_\_\_\_\_

Total Depth \_\_\_\_\_

PRODUCTION

1st 24 hrs. Nat. \_\_\_\_\_

1st 24 hrs. after shot \_\_\_\_\_

Gas \_\_\_\_\_ Cu. Ft.

Dry Hole \_\_\_\_\_

Abandoned \_\_\_\_\_

Date (over)

FEB 22 1950 19

J. E. TYRA Scout

36 shots 3079-88 water  
Squeezed off

~~shot 3088-98 water~~

PB 3065

36 shots 3015-54

1000 acid

open flow 1,000,000 cu. ft. per day

Comp.

UNITED STATES

RECEIVED

TO ORDER

|  |  |  |
|--|--|--|
|  |  |  |
|  |  |  |
|  |  |  |
|  |  |  |
|  |  |  |

FEB 24 1930

|                |                |
|----------------|----------------|
| Scout Cards    | <i>Edith</i>   |
| Land Small Map | .....          |
| Land Wall Map  | <i>E</i> ..... |
| Tracings       | .....          |
| France Map     | .....          |
| Pierce Map     | .....          |
| Misc.          | .....          |