

Beulah

Map No. **KANSAS** Sec. *22* Twp. *27* R. *5*


Well No. *4-A* *Mc Gray* Farm
Empire Oil R. Company

990 Ft. from N. Line

..... Ft. from S. Line

990 Ft. from E. Line

..... Ft. from W. Line

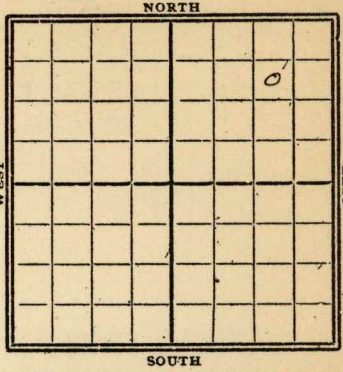

1928

Date	REPORT
<i>10/31</i>	<i>Location</i>
<i>11/7</i>
<i>11/14</i>
<i>11/21</i>	<i>Timbers</i>
<i>11/28</i>	<i>Bldg Rig</i>
<i>12/5</i>	<i>Rig up</i>
<i>12/12</i>	<i>Wrlg 400</i>
<i>12/19</i>	<i>" 1085'</i>
<i>12/26</i>	<i>" 1520'</i>
<i>1929</i>	
<i>1/2</i>	<i>" 2210 2225'</i>
<i>1/9</i>	<i>" 2326'</i>
<i>1/16</i>	<i>sand 2710-57'</i> <i>swabbed 27 bbls</i> <i>in 15 hrs.</i>
<i>1/23</i>	<i>sand 2710-57'</i> <i>T.D. 2757'</i> <i>shot 100 gts</i> <i>150 bbls oil</i> <i>Pump.</i>

Butler

K11 KANSAS

MAP NO. _____ SEC. 22 TWP. 27 R. 5

WELL NO. 4^A _____

Empire Oil & Gas Co

COMPANY

CONTRACTOR

FIRST REPORTS

SECTION PLAT

990 FT. FROM N. LINE

FT. FROM S. LINE

990 FT. FROM E. LINE

FT. FROM W. LINE

			0

LOCATION ✓ _____

RIG UP _____

DRILLING AND REMARKS:

RECORD

CASED _____ IN. _____ FT.

SAND _____

GAS _____

OIL _____

TOTAL DEPTH _____

PRODUCTION

1ST 24 HRS. NAT. _____

1ST 24 HRS. AFTER SHOT _____

GAS _____ CU. FT.

DRY HOLE _____

ABANDONED _____

DATE

OCT 31 1928

CHAS. L. SHERWOOD

192

SCOUT

Map No. **K11** **KANSAS** Sec. **22** Twp. **27** R. **5**

Well No. **4 A** **McCray Co**

Empire Oil Co Company

Contractor

COMPLETE

SECTION PLAT

990 Ft. from N. Line

Ft. from S. Line

990 Ft. from E. Line

Ft. from W. Line

			0

Location

Rig up

Drilling and Remarks:

100/150 lbs.

RECORD

Cased in., ft.

Sand **2710-2757**

Gas

Oil

Total Depth **2757**

PRODUCTION

1st 24 hrs. Nat.

1st 24 hrs. after shot

Gas Cu. Ft.

Dry Hole

Abandoned

Date

JAN 23 1929

CHAS. L. SHERWOOD

192

Scout