

Rooks


KANSAS

DX 78-1

Section 33 Township 8 Range 18W

Well No. #1 Carmichael-Moser

Company Petroleum Inc.

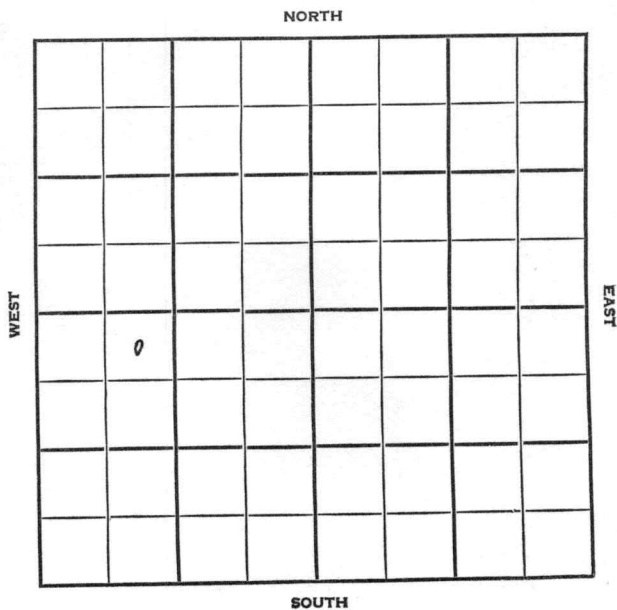

SEC.	TWP.	R.
33	8	18W
WELL NO. #1 Carmichael-Moser		
FARM		
COMPANY Petroleum Inc.		
CONTRACTOR		


**Nye & Snell
Wildcat.**

330 Ft. from N. Line

_____ Ft. from S. Line

_____ Ft. from E. Line


990 Ft. from W. Line

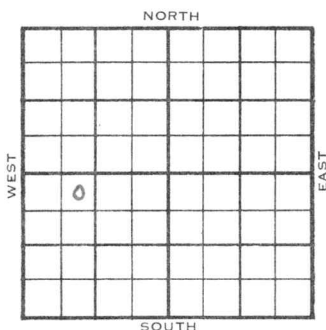

NE NWSW

1954	ELEVATION 1998'	REPORT
12/15	Spud 12-9-54 8" @ 200' Drlg. 2810'	
1955 2/23	Spud 12-9-54 Oil Well TD 3440' 8" @ 200' Heeb 3132', Tor. 3154' Lans 3175' DST 3137'-3200' opn 1 hr rec 120' gas, 120' ocm, 120' hocm, 120' froggy oil 60' clean oil, 1100# DST 3196'-3222' opn 1 hr, rec 75' ocm 500' froggy oil, 990# DST 3238'-68' opn 1 hr, gas in 4 min rec 30' hocm, 30' froggy oil, 2175' clean oil, 800# DST 3266'-68' opn 1 hr, rec 150' Muddy SW 0# Arb. 3429' TD 3432' 5" @ 3431' DD 3440' B/ 1 goph 250 A B/ 8 goph PB Perf 3259-63 250 A S/ 20 boph PB 32/ 3210-18 500 A S/ 21 boph Comp 474 bopd.	

COMPLETED

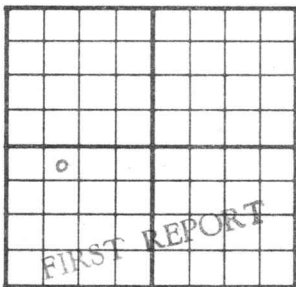County Rooks State KansasSec. 33 (Blk.) 8 (Sur.) 18W Map No.Operator Petroleum Inc.Well No. 1 Farm Carmichael-MoserElev. Location NE NW SW330 Ft. From N Line SW990 Ft. From W Line Quarter1st. Report DEC 15 1954


Completion

Remarks

Nye & Snell - Contr.Spudding Date 12-9-54Drlg. Data Wildcat8" @ 200 drlg. 2810

FABEN GILSTRAP

County _____ Rocks _____ State Kansas
 Sec. 33 (Blk.) 8 (Sur.) 18W Map No. _____
 Operator Petroleum Inc.
 Well No. 1 Farm Carmichael-Moser
 Elev. 1998 Location NE NW SW

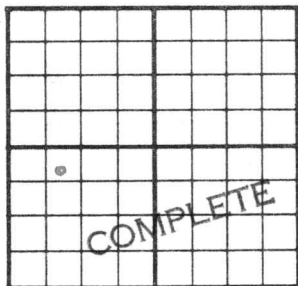

330 Ft. From N Line SW
990 Ft. From W Line Quarter
 1st. Report _____
 Completion FEB 23 1955
 Remarks Carmichael Pool
Nye & Snell - Contr.
 Spudding Date 12-9-54

Drlg. Data Oil well TD 3440
8" @ 200 Heeb. 3132 Tor. 3154
Lans. 3175 DST 3137-3200 open 1 hr.
Rec. 120' gas 120' ocm 120' hocm
120' froggy oil 60' clean oil 1100#
DST 3196-3222 open 1 hr. Rec. 75' ocm
500' froggy oil 990# DST 3238-68
open 1 hr. gas in 4 min. Rec. 30' hocm
30' froggy oil 2125' clean oil 800#
DST 3266-68 open 1 hr. Rec. 150' muddy
sw 0# Arb. 3429 TD 3432 5" @ 3431
DD 3440 B/ 1 goph 250 A B/ 8 goph
PB perf/ 3259-63 250 A S/ 20 boph
PB 32/ 3210-18 500 A S/ 21 boph
Comp. 474 bopd

FABEN GILSTRAP